




5 cm

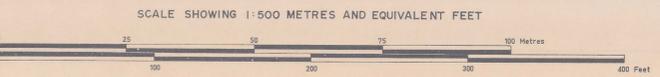

0055_301

MICROFILMED


DEPARTMENT OF MINES
 BROUGHT TO DATE: 31 DEC 1979
 MINE MANAGER: *[Signature]*
 MINE SURVEYOR: *[Signature]*

ELECTROLYTIC ZINC COMPANY OF AUSTRALASIA LIMITED
 WEST COAST MINES, T.A.S.

SURVEY BY		SCALE	1:500
DRAWN BY		DATE	1975
TRACED BY	I.T.M.	REFERENCE	

ROSEBERY MINE
 N° 17 LEVEL (3)

DRAWING N°:

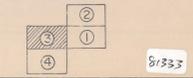

0055_301

81333