


5cm

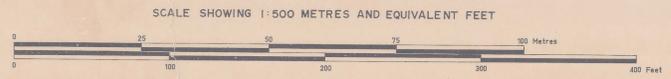

ELECTROLYTIC ZINC COMPANY OF AUSTRALASIA LIMITED  
WEST COAST MINES, T.A.S.

SURVEY BY		SCALE	1:500
DRAWN BY		DATE	1975
TRACED BY	I.T.M.	REFERENCE	

ROSEBERY MINE  
No 17 LEVEL (2)

0055\_302

**MICROFILMED**

DEPARTMENT OF MINES  
BROUGHT TO DATE 31 DEC 1979  
MINE MANAGER: *ABM*  
MINE SURVEYOR: *AS*

DRAWING No: 2



0/332

0055\_302