


0055_304

0055_304

DEPARTMENT OF MINES
 BROUGHT TO DATE: 31 DEC 1979
 MINE MANAGER: *McMinn*
 MINE SURVEYOR: *McKinn*

MICROFILMED

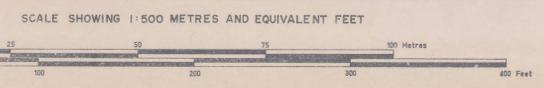

ELECTROLYTIC ZINC COMPANY OF AUSTRALASIA LIMITED
 WEST COAST MINES, T.A.S.

SURVEY BY		SCALE	1:500
DRAWN BY		DATE	1975
TRACED BY	RJR	REFERENCE	

ROSEBERY MINE
 No 12 LEVEL (2)

DRAWING No:

① ② ③

8/3/8