


DEPARTMENT OF MINES
 BROUGHT TO DATE 31 DEC 1979
 MINE MANAGER *[Signature]*
 MINE SURVEYOR *[Signature]*

0055_305

MICROFILMED

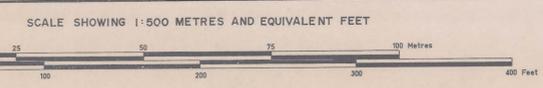

ELECTROLYTIC ZINC COMPANY OF AUSTRALASIA LIMITED
 WEST COAST MINES, T.A.S.

SURVEY BY	SCALE	1:500
DRAWN BY	DATE	1975
TRACED BY I.T.M.	REFERENCE	

ROSEBERY MINE
 No 14 LEVEL (2)

DRAWING No: 5 6
3 4
1 2

8/223

0055_305