

DEPARTMENT OF MINES
 BROUGHT TO DATE: 31 DEC 1979
 MINE MANAGER *[Signature]*
 MINE SURVEYOR *[Signature]*

0055_306

MICROFILMED

ELECTROLYTIC ZINC COMPANY OF AUSTRALASIA LIMITED
 WEST COAST MINES, TAS.


SURVEY BY		SCALE	1:500
DRAWN BY		DATE	1975
TRACED BY	I.T.M.	REFERENCE	

ROSEBERY MINE
 N° 14 LEVEL ①

DRAWING N°:

⑤	⑥
③	④
①	②

81322

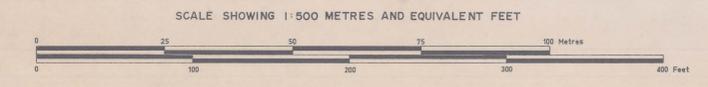

0055_306