


0055\_308

DEPARTMENT OF MINES  
 BROUGHT TO DATE: 31 DEC 1979  
 MINE MANAGER: *A.M. Munn*  
 MINE SURVEYOR: *M. J. ...*

0055\_308

MICROFILMED

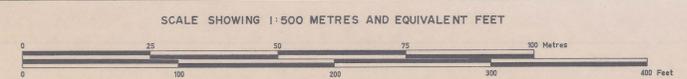

ELECTROLYTIC ZINC COMPANY OF AUSTRALASIA LIMITED  
 WEST COAST MINES, T.A.S.

SURVEY BY		SCALE	1:500
DRAWN BY		DATE	1975
TRACED BY	I.T.M.	REFERENCE	

ROSEBERY MINE  
 N° 13 LEVEL ①

DRAWING N°: ①

31/320