


0055_309

DEPARTMENT OF MINES
 BROUGHT TO DATE: 31 DEC 1979
 MINE MANAGER: *A. W. ...*
 MINE SURVEYOR: *J. ...*

MICROFILMED

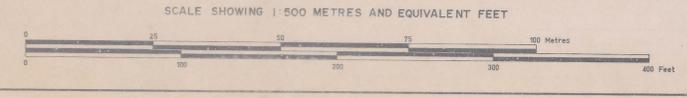

ELECTROLYTIC ZINC COMPANY OF AUSTRALASIA LIMITED
 WEST COAST MINES, TAS.

SURVEY BY		SCALE	1:500
DRAWN BY		DATE	1975
TRACED BY	RJR	REFERENCE	

ROSEBERY MINE
 No 12 LEVEL (3)

DRAWING No.:
 ① ② ③

81319

0055_309