


0055\_310

DEPARTMENT OF MINES  
 BROUGHT TO DATE: 31 DEC 1979  
 MINE MANAGER: *[Signature]*  
 MINE SURVEYOR: *[Signature]*

**MICROFILMED**

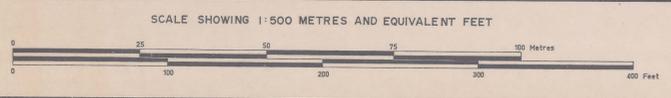

**ELECTROLYTIC ZINC COMPANY OF AUSTRALASIA LIMITED**  
 WEST COAST MINES, T.A.S.

SURVEY BY		SCALE	1 : 500
DRAWN BY		DATE	1975
TRACED BY	RJR	REFERENCE	

ROSEBERY MINE  
 No 12 LEVEL (1)

DRAWING No: **1**

8/317

0055\_310