


0055\_311

MICROFILMED

DEPARTMENT OF MINES  
 BROUGHT TO DATE: 31 DEC 1979  
 MINE MANAGER: *[Signature]*  
 MINE SURVEYOR: *[Signature]*

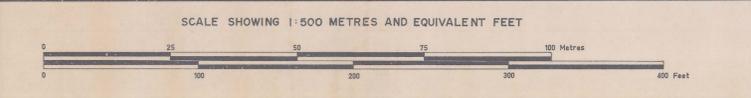

ELECTROLYTIC ZINC COMPANY OF AUSTRALASIA LIMITED  
 WEST COAST MINES, TAS.

SURVEY BY		SCALE	1 : 500
DRAWN BY		DATE	1975
TRACED BY	RJR	REFERENCE	

ROSEBERY MINE  
 No 11 LEVEL (3)

DRAWING NO.:  
 ① ② ③  
 815/6