


DEPARTMENT OF MINES
 BROUGHT TO DATE 31 DEC 1979
 MINE MANAGER *M. Hammett*
 MINE SURVEYOR *A. J. ...*

0055_312

MICROFILMED

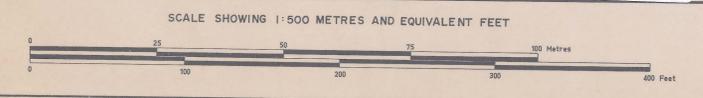

ELECTROLYTIC ZINC COMPANY OF AUSTRALASIA LIMITED
 WEST COAST MINES, T.A.S.

SURVEY BY		SCALE	1:500
DRAWN BY		DATE	1975
TRACED BY	RJR	REFERENCE	

ROSEBERY MINE
 N° 10 LEVEL (1)

DRAWING N°:
 ② ③

8/3-5

0055_312