


0055\_313

DEPARTMENT OF MINES 31 DEC 1979  
 BROUGHT TO DATE  
 MINE MANAGER: *Abraham*  
 MINE SURVEYOR: *John*

MICROFILMED

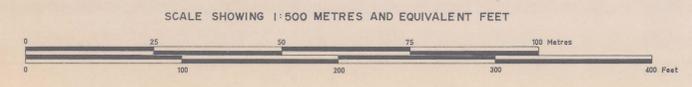

ELECTROLYTIC ZINC COMPANY OF AUSTRALASIA LIMITED  
 WEST COAST MINES, T.A.S.

SURVEY BY		SCALE	1:500
DRAWN BY		DATE	1975
TRACED BY	RJR	REFERENCE	

ROSEBERY MINE  
 N° 9 LEVEL ①

DRAWING N°:  
 ① ② ③  
 8/3/79