


0055_314

0055_314

DEPARTMENT OF MINES 31 DEC 1979
 BROUGHT TO DATE:
 MINE MANAGER: *[Signature]*
 MINE SURVEYOR: *[Signature]*

MICROFILMED

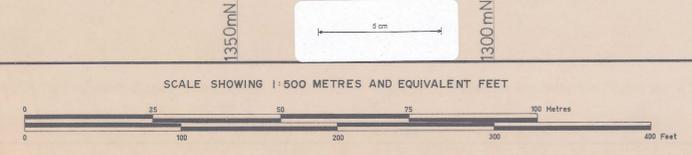

ELECTROLYTIC ZINC COMPANY OF AUSTRALASIA LIMITED
 WEST COAST MINES, TAS.

SURVEY BY		SCALE	1:500
DRAWN BY		DATE	1975
TRACED BY	I.T.M.	REFERENCE	

ROSEBURY MINE
 No 8 LEVEL (1)

DRAWING NO.:

①	②	③
④		

8132