




0055_318

0055_318

MICROFILMED

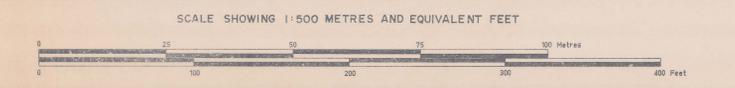

ELECTROLYTIC ZINC COMPANY OF AUSTRALASIA LIMITED
WEST COAST MINES, T.A.S.

SURVEY BY		SCALE	1:500
DRAWN BY		DATE	1978
TRACED BY	A.G.M.	REFERENCE	

ROSEBERY MINE
No 16 LEVEL (1)

DEPARTMENT OF MINES
BROUGHT TO DATE **31 DEC 1979**
MINE MANAGER *[Signature]*
MINE SURVEYOR *[Signature]*

DRAWING No:

①
②

 8/325