


0055_319

0055_319

DEPARTMENT OF MINES
 BROUGHT TO DATE 31 DEC 1979
 MINE MANAGER *A.H. Hume*
 MINE SURVEYOR *J.P. Hester*

MICROFILMED

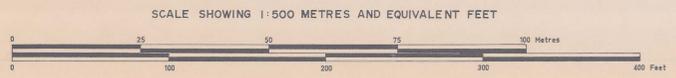

ELECTROLYTIC ZINC COMPANY OF AUSTRALASIA LIMITED
 WEST COAST MINES, T.A.S.

SURVEY BY		SCALE	
DRAWN BY		DATE	
TRACED BY		REFERENCE	

ROSEBERY MINE
 N° 15 LEVEL (5)

DRAWING N°:

4	1	2	3
5			

3/827