


0055_321

BROUGHT TO DATE: 31 DEC 1979
 MINE MANAGER: *Abraham*
 MINE SURVEYOR: *John*

MICROFILMED

DRAWING N°:
 DEPARTMENT OF MINES
8/306

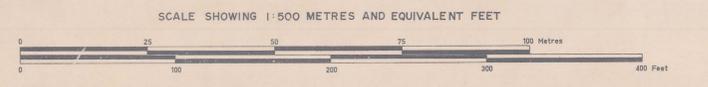

ELECTROLYTIC ZINC COMPANY OF AUSTRALASIA LIMITED
 WEST COAST MINES, T.A.S.

SURVEY BY
 DRAWN BY
 TRACED BY S.M. Burrows

SCALE 1:500 metres
 DATE 1973
 REFERENCE

ROSEBERY MINE
 LONGITUDINAL PROJECTION
 400mS-200mN — BELOW 10 / L