


BULK STOPES MINED

BROUGHT TO DATE **31 DEC 1979**
 MINE MANAGER *[Signature]*
 MINE SURVEYOR *[Signature]*

0055_322

MICROFILMED

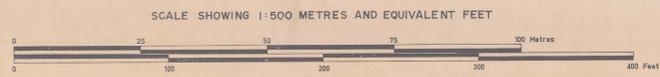

ELECTROLYTIC ZINC COMPANY OF AUSTRALASIA LIMITED
 WEST COAST MINES, T.A.S.

SURVEY BY	SCALE	1	500
DRAWN BY	DATE	1973	
TRACED BY P. J. Lowe	REFERENCE		

ROSEBERY MINE
 LONGITUDINAL PROJECTION
 H.W. STOPES

DRAWING N^o:
 DEPARTMENT OF MINES



0055_322