


0 cm

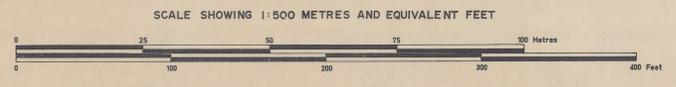

ELECTROLYTIC ZINC COMPANY OF AUSTRALASIA LIMITED
WEST COAST MINES, T.A.S.

SURVEY BY		SCALE	1 : 500
DRAWN BY		DATE	1973
TRACED BY	P.J. Lowe	REFERENCE	

0055_326

MICROFILMED

BROUGHT TO DATE : 31 DEC 1978
MINE MANAGER : *A.M. ...*
MINE SURVEYOR : *J.M. ...*

HERCULES MINE
LONGITUDINAL PROJECTION

79003

DRAWING N°:
DEPARTMENT OF MINES

0055_326