


0055_327



5 cm

SCALE SHOWING 1:500 METRES AND EQUIVALENT FEET

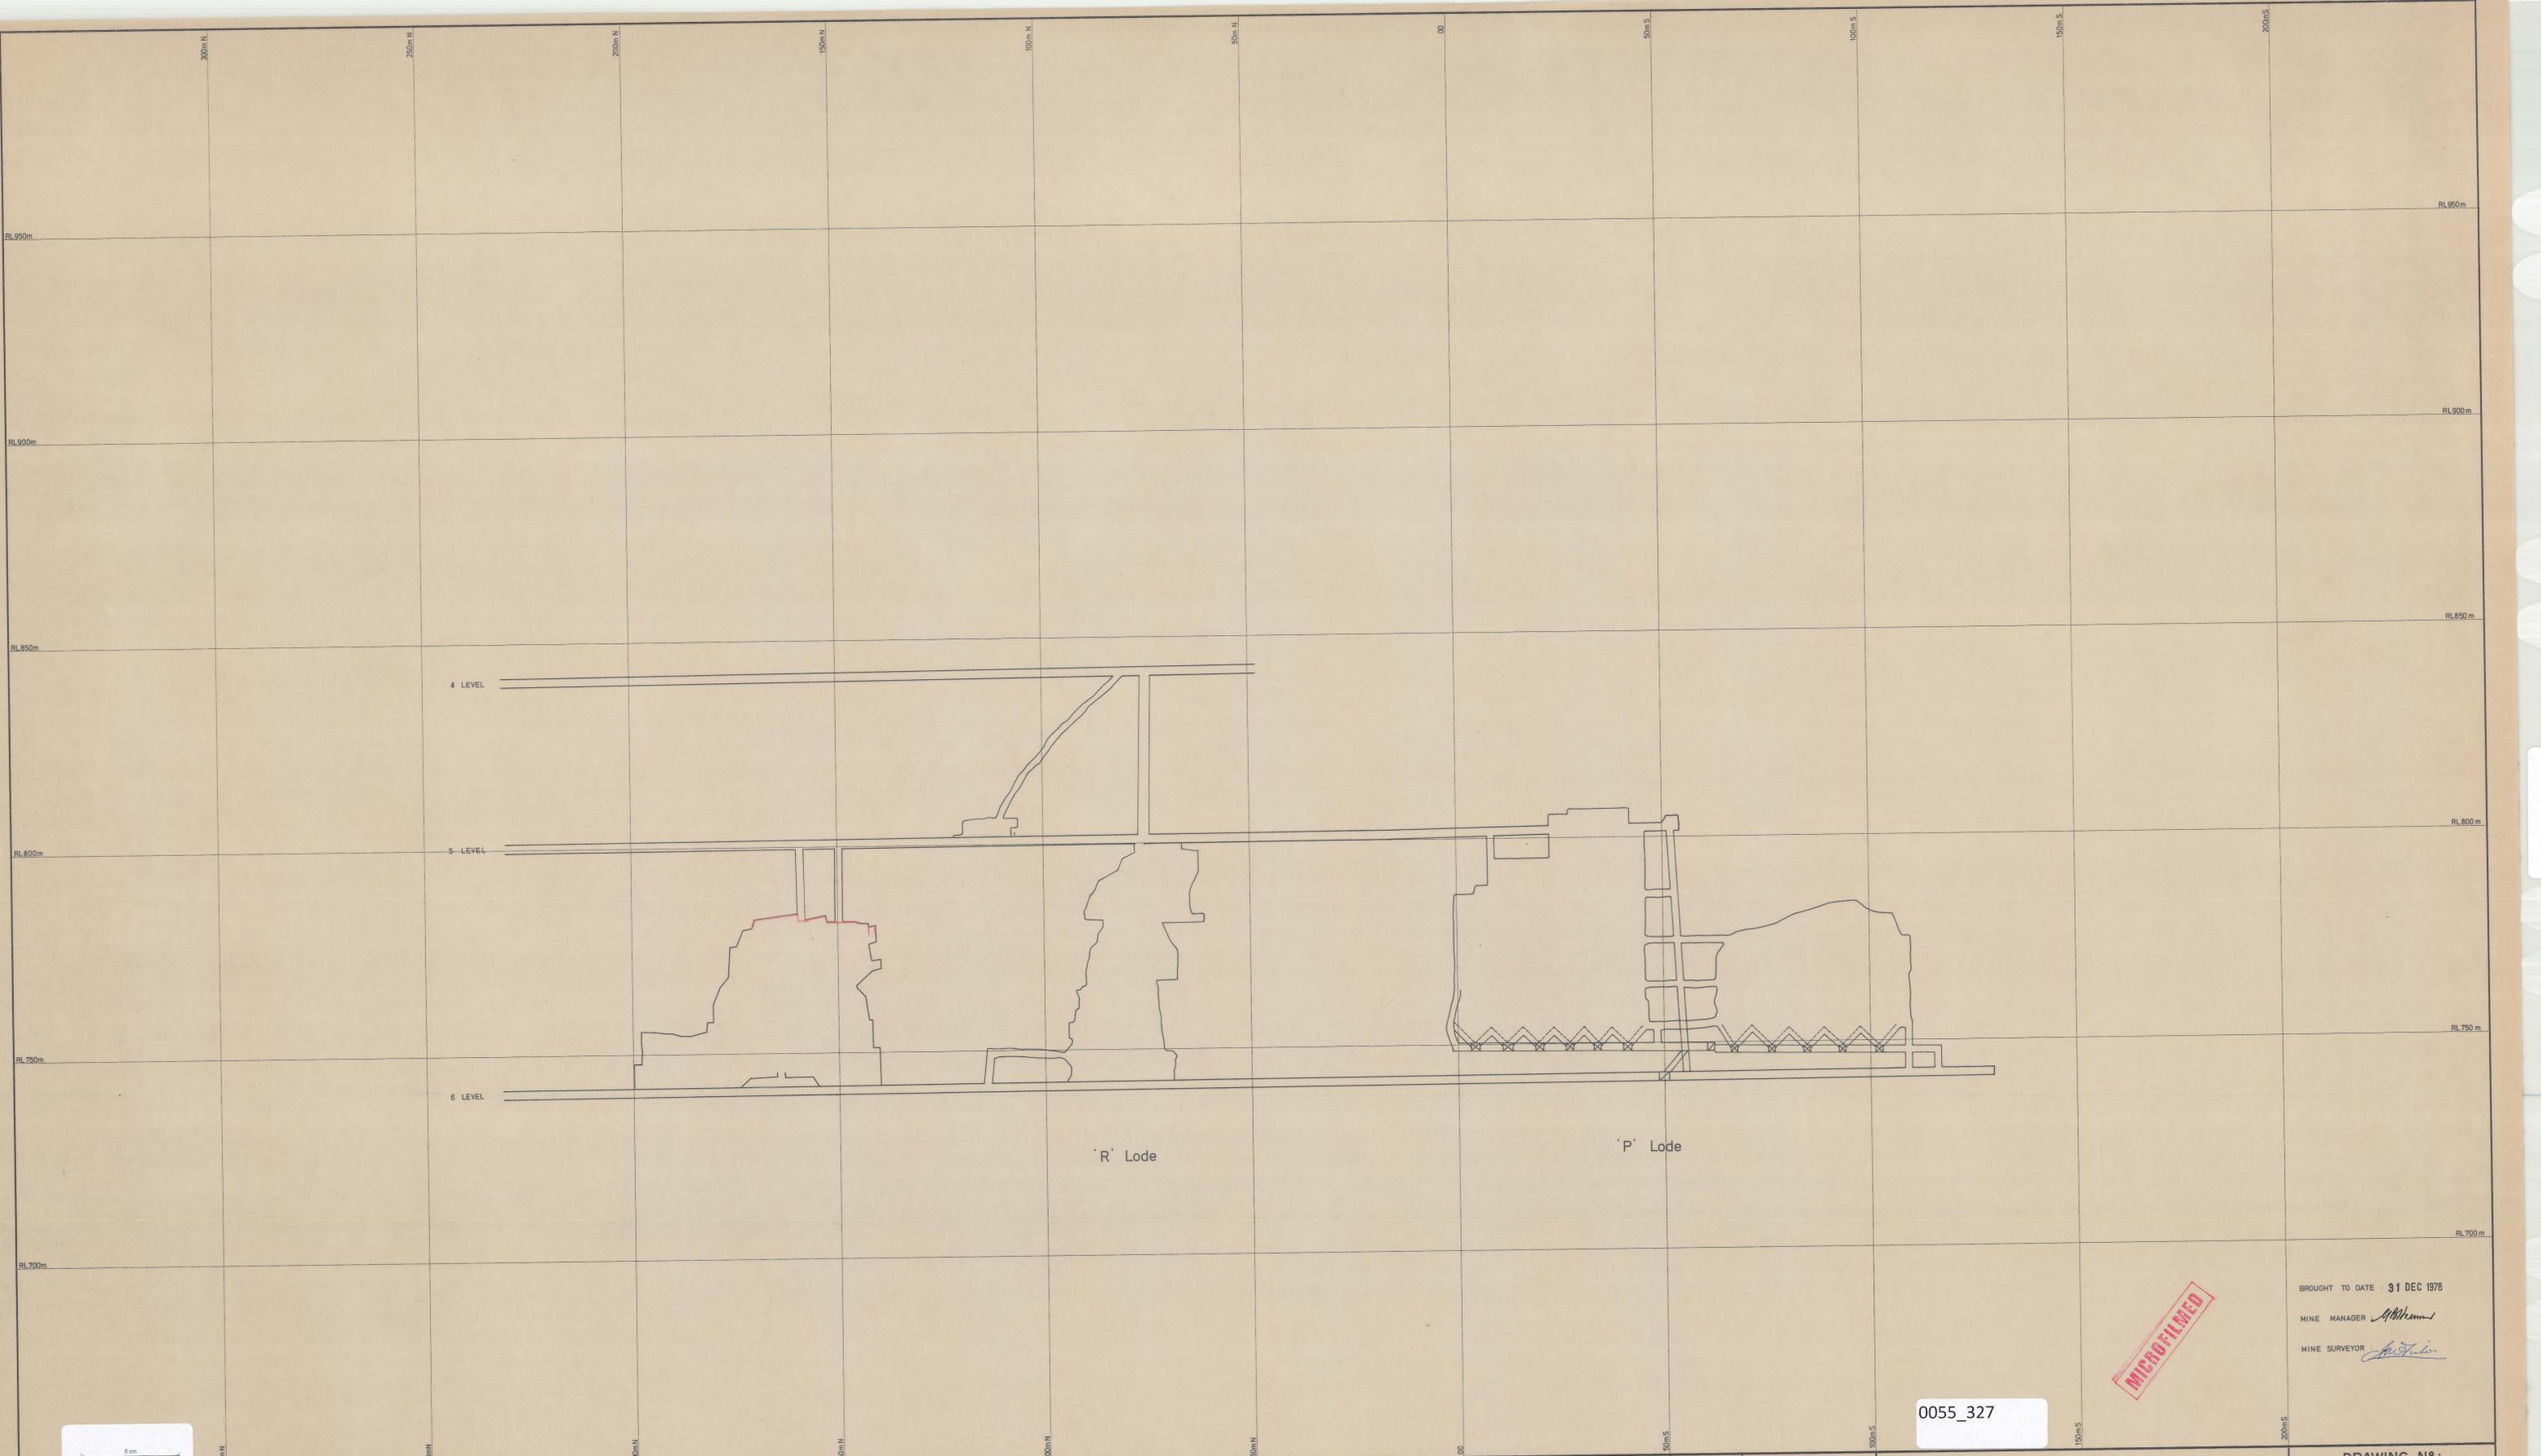

ELECTROLYTIC ZINC COMPANY OF AUSTRALASIA LIMITED
 WEST COAST MINES, T.A.S.

SURVEY BY		SCALE	1 : 500
DRAWN BY		DATE	1973
TRACED BY	P.J. Lowe	REFERENCE	

0055_327

HERCULES MINE
 LONGITUDINAL PROJECTION

79002

BROUGHT TO DATE : 31 DEC 1978
 MINE MANAGER *[Signature]*
 MINE SURVEYOR *[Signature]*

DRAWING N°:
 DEPARTMENT OF MINES