


MICROFILMED

0055_328

BROUGHT TO DATE: 31 DEC 1978
 MINE MANAGER *[Signature]*
 MINE SURVEYOR *[Signature]*

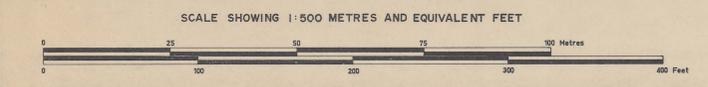

ELECTROLYTIC ZINC COMPANY OF AUSTRALASIA LIMITED
 WEST COAST MINES, T.A.S.

SURVEY BY		SCALE	1 : 500 METRES
DRAWN BY		DATE	1973
TRACED BY	P. J. Lowe	REFERENCE	

HERCULES MINE
 No. 5 LEVEL
 100m.S - 500m.N

79001

DRAWING No.:
 DEPARTMENT OF MINES
 PLAN

0055_328