


BROUGHT TO DATE **31 DEC 1979**
 MINE MANAGER *ABW*
 MINE SURVEYOR *AS*

0055_329

MICROFILMED

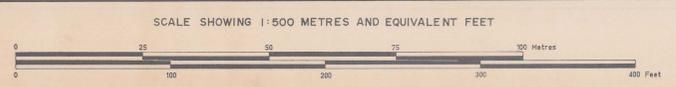

ELECTROLYTIC ZINC COMPANY OF AUSTRALASIA LIMITED
 WEST COAST MINES, T.A.S.

SURVEY BY		SCALE	1:500
DRAWN BY		DATE	20.3.80
TRACED BY	G.M. BENNETT	REFERENCE	

HERCULES MINE
 N° 7 LEVEL 2

DRAWING N°:
 ① ②
 9/302

0055_329