


BROUGHT TO DATE : 31 DEC 1979  
 MINE MANAGER : *[Signature]*  
 MINE SURVEYOR : *[Signature]*

0055\_330

MICROFILMED

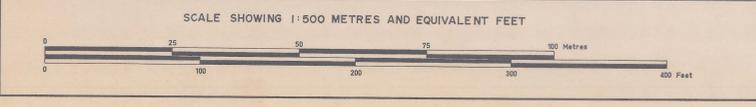

ELECTROLYTIC ZINC COMPANY OF AUSTRALASIA LIMITED  
 WEST COAST MINES, T.A.S.

SURVEY BY		SCALE	1:500
DRAWN BY		DATE	4.9.79
TRACED BY	G.M.BENNETT	REFERENCE	

HERCULES MINE  
 N° 7 LEVEL ①

DRAWING N° :  
 ②

0055\_330

8/361