
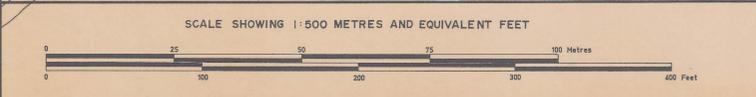


0055_336

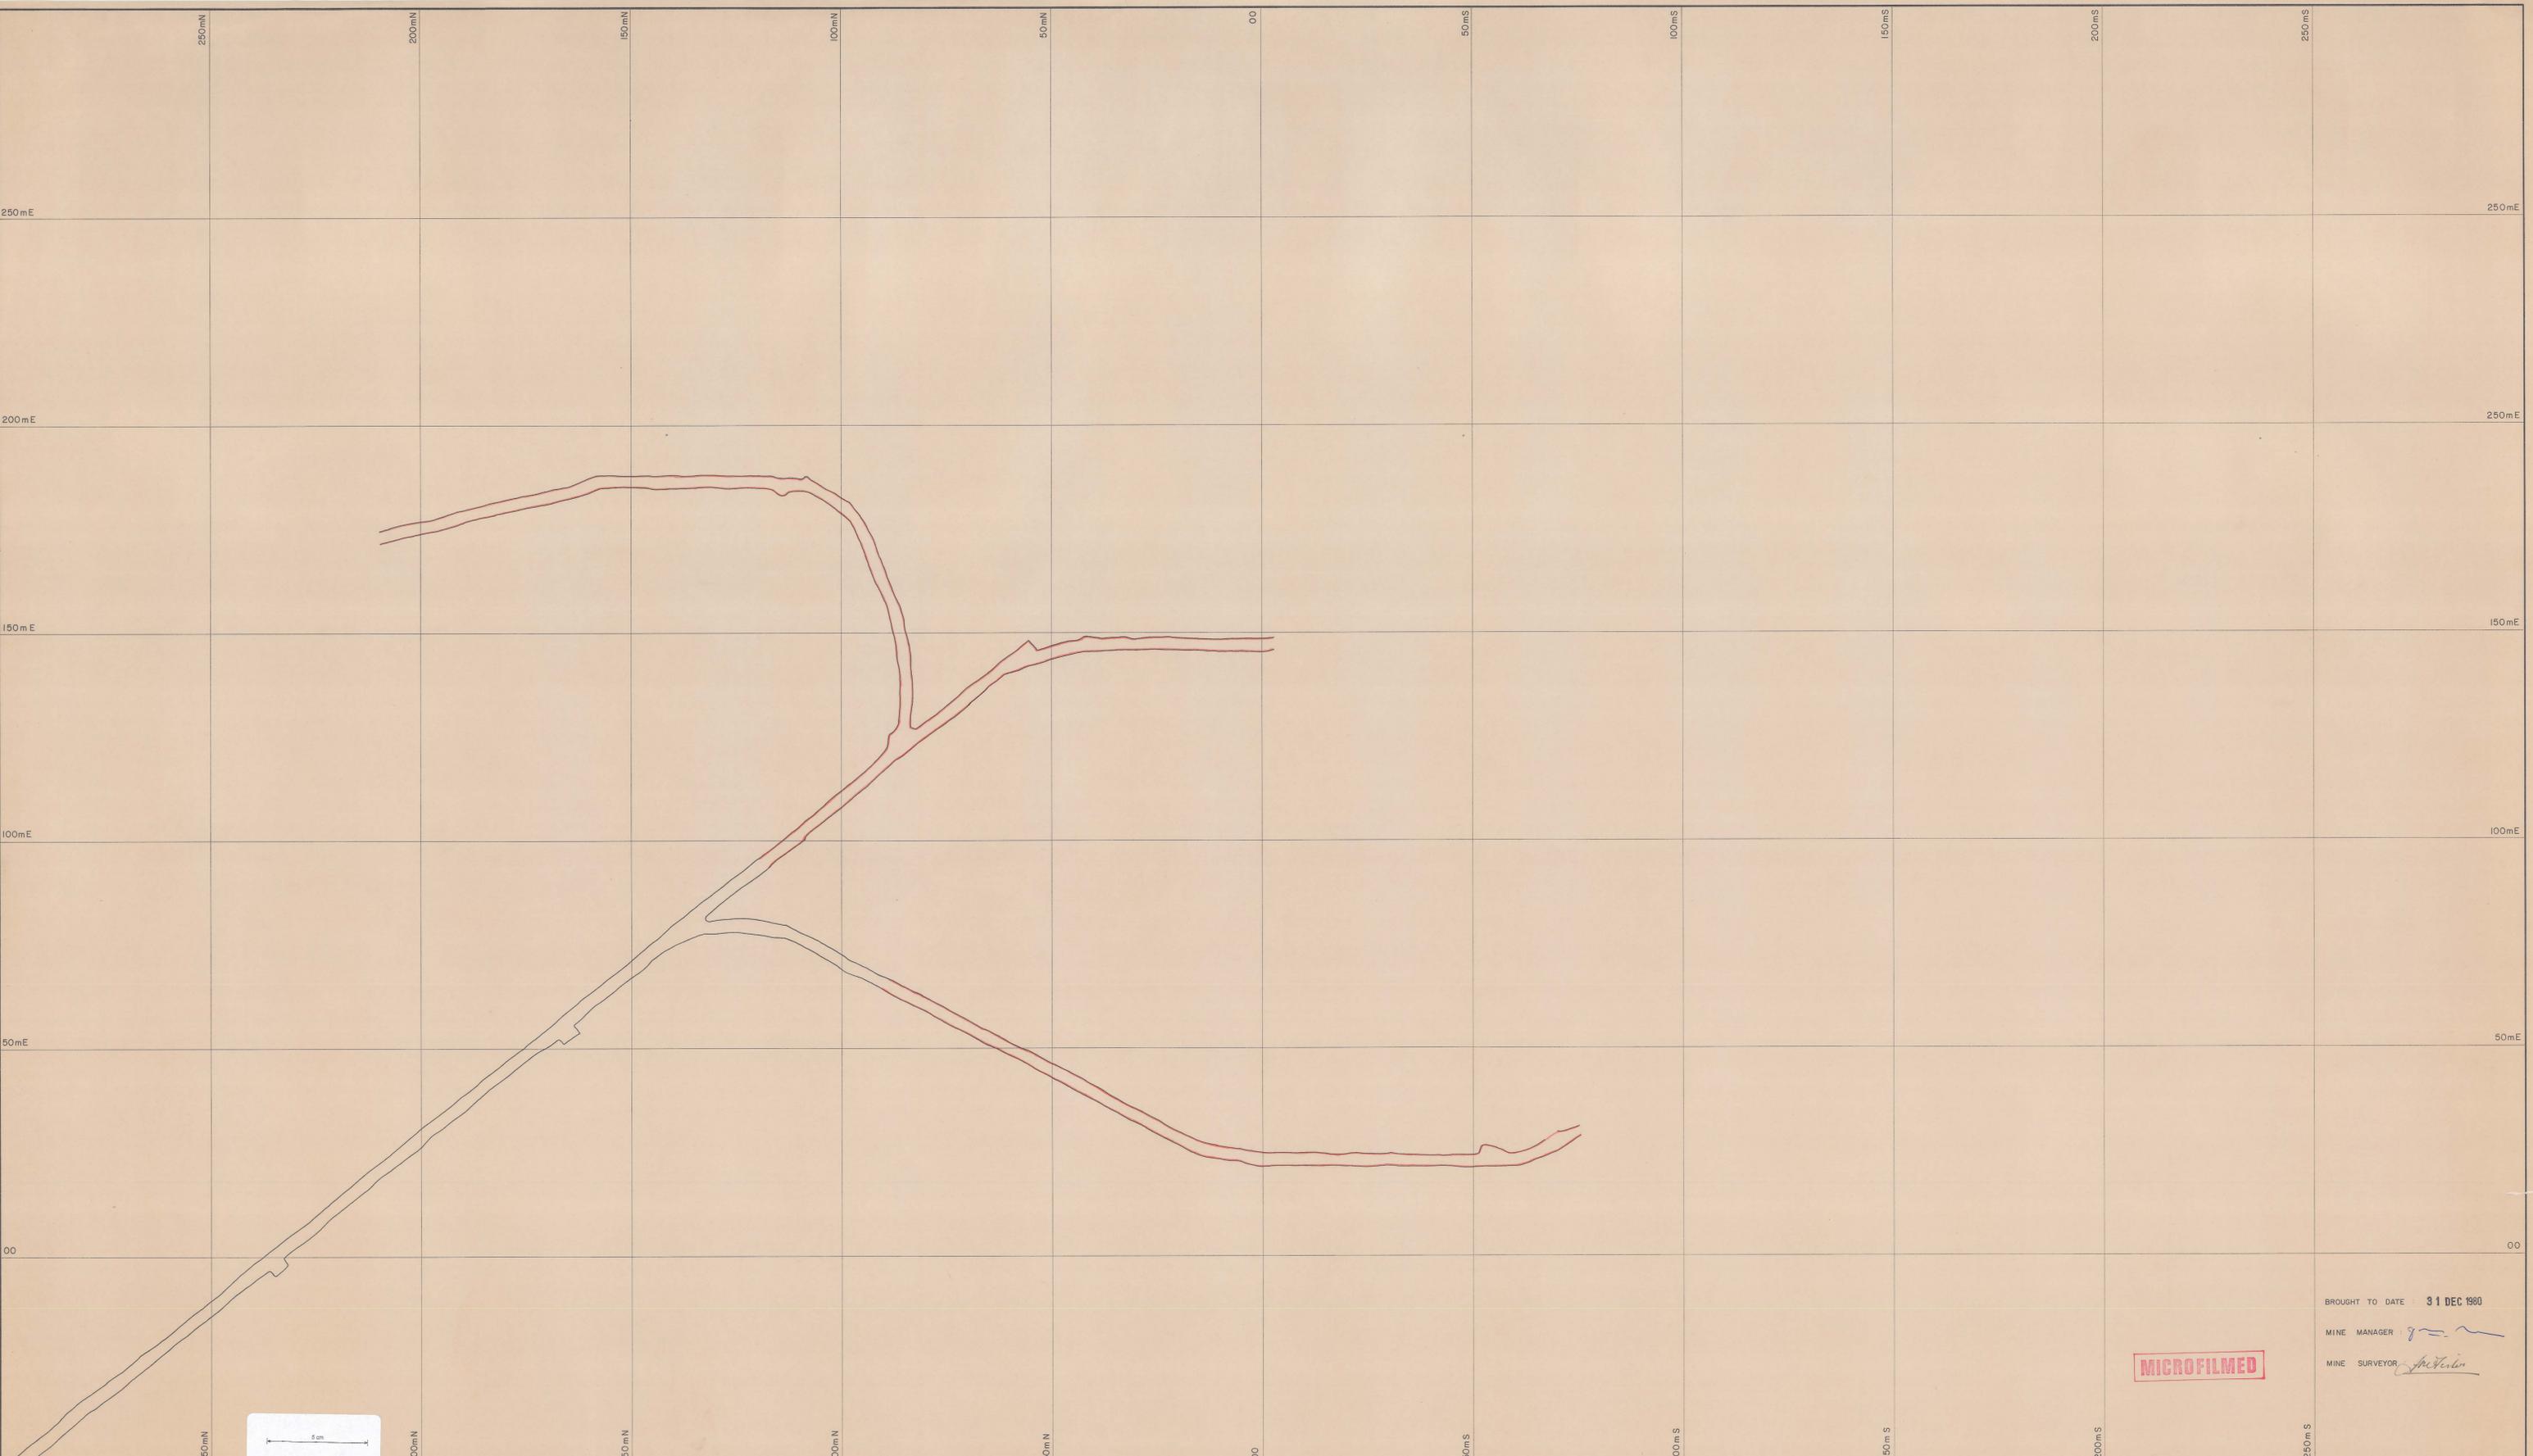

ELECTROLYTIC ZINC COMPANY OF AUSTRALASIA LIMITED
WEST COAST MINES, T.A.S.

SURVEY BY		SCALE	1:500
DRAWN BY		DATE	20.3.80
TRACED BY	G.M. BENNETT	REFERENCE	

HERCULES MINE
No. 7 LEVEL (2)

0055_336

DRAWING No.:
① 81371

MICROFILMED

BROUGHT TO DATE - 31 DEC 1980
MINE MANAGER: *[Signature]*
MINE SURVEYOR: *[Signature]*