




0055_337

BROUGHT TO DATE : 31 DEC 1980
 MINE MANAGER : *[Signature]*
 MINE SURVEYOR : *[Signature]*

MICROFILMED

0055_337

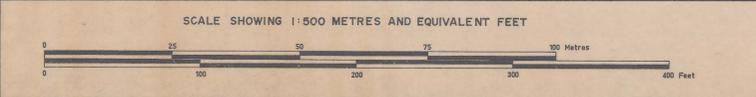

ELECTROLYTIC ZINC COMPANY OF AUSTRALASIA LIMITED
 WEST COAST MINES, T.A.S.

SURVEY BY		SCALE	1 : 500 METRES
DRAWN BY		DATE	1973
TRACED BY	P. J. Lowe	REFERENCE	

HERCULES MINE
 No 4 LEVEL
 00 - 600m.N

DRAWING No :
 DEPARTMENT OF MINES
 PLAN

81370