




0055_340

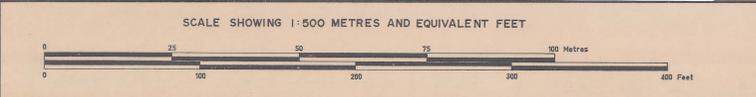

ELECTROLYTIC ZINC COMPANY OF AUSTRALASIA LIMITED
WEST COAST MINES, T.A.S.

SURVEY BY		SCALE	1 : 500
DRAWN BY		DATE	1973
TRACED BY	P.J. Lowe	REFERENCE	

HERCULES MINE
LONGITUDINAL PROJECTION

DRAWING NO.:
DEPARTMENT OF MINES

BROUGHT TO DATE : 31 DEC 1980
MINE MANAGER : *[Signature]*
MINE SURVEYOR : *[Signature]*

MICROFILMED

0055_340

81367