



0055_342

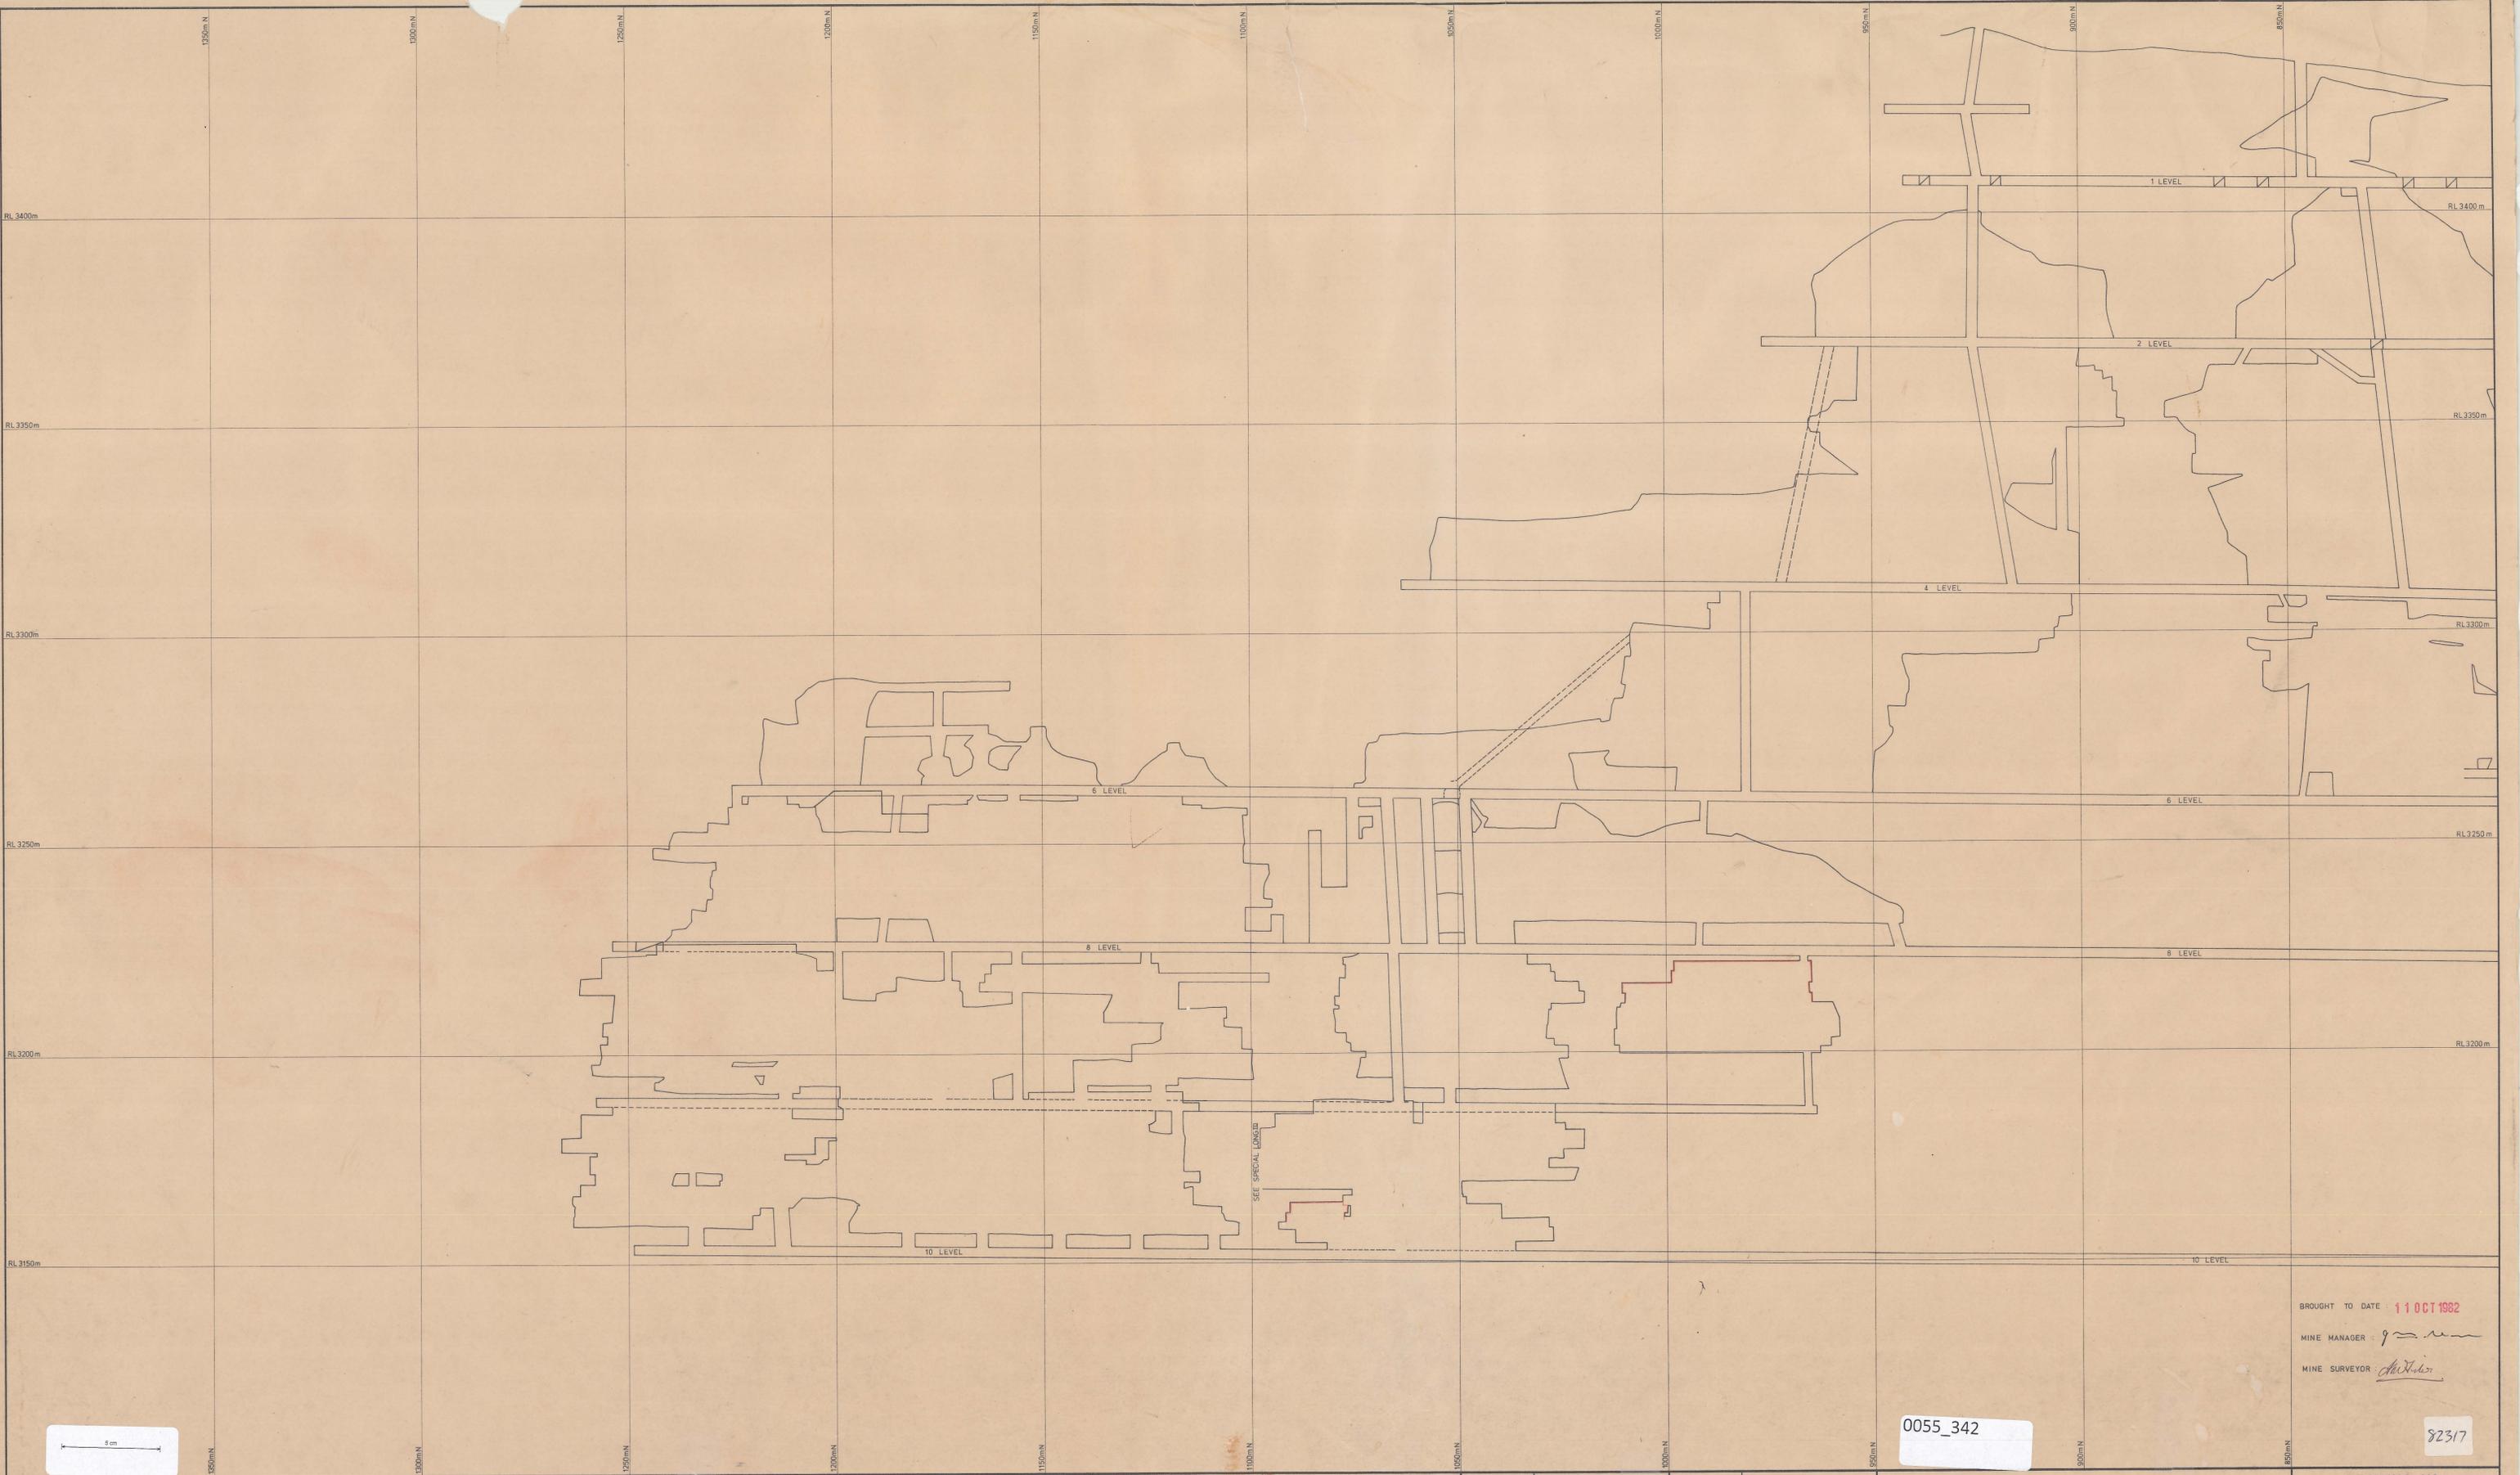

BROUGHT TO DATE: 11 OCT 1982
 MINE MANAGER: *[Signature]*
 MINE SURVEYOR: *[Signature]*

0055_342

82317

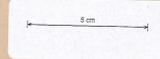

SCALE SHOWING 1:500 METRES AND EQUIVALENT FEET



ELECTROLYTIC ZINC COMPANY OF AUSTRALASIA LIMITED
 WEST COAST MINES, T.A.S.

SURVEY BY		SCALE	1 : 500
DRAWN BY		DATE	1973
TRACED BY	P.J. Lowe	REFERENCE	

ROSEBERY MINE
 LONGITUDINAL PROJECTION
 NORTH END — ABOVE 10/L.

DRAWING N^o:
 DEPARTMENT OF MINES