



0055_343

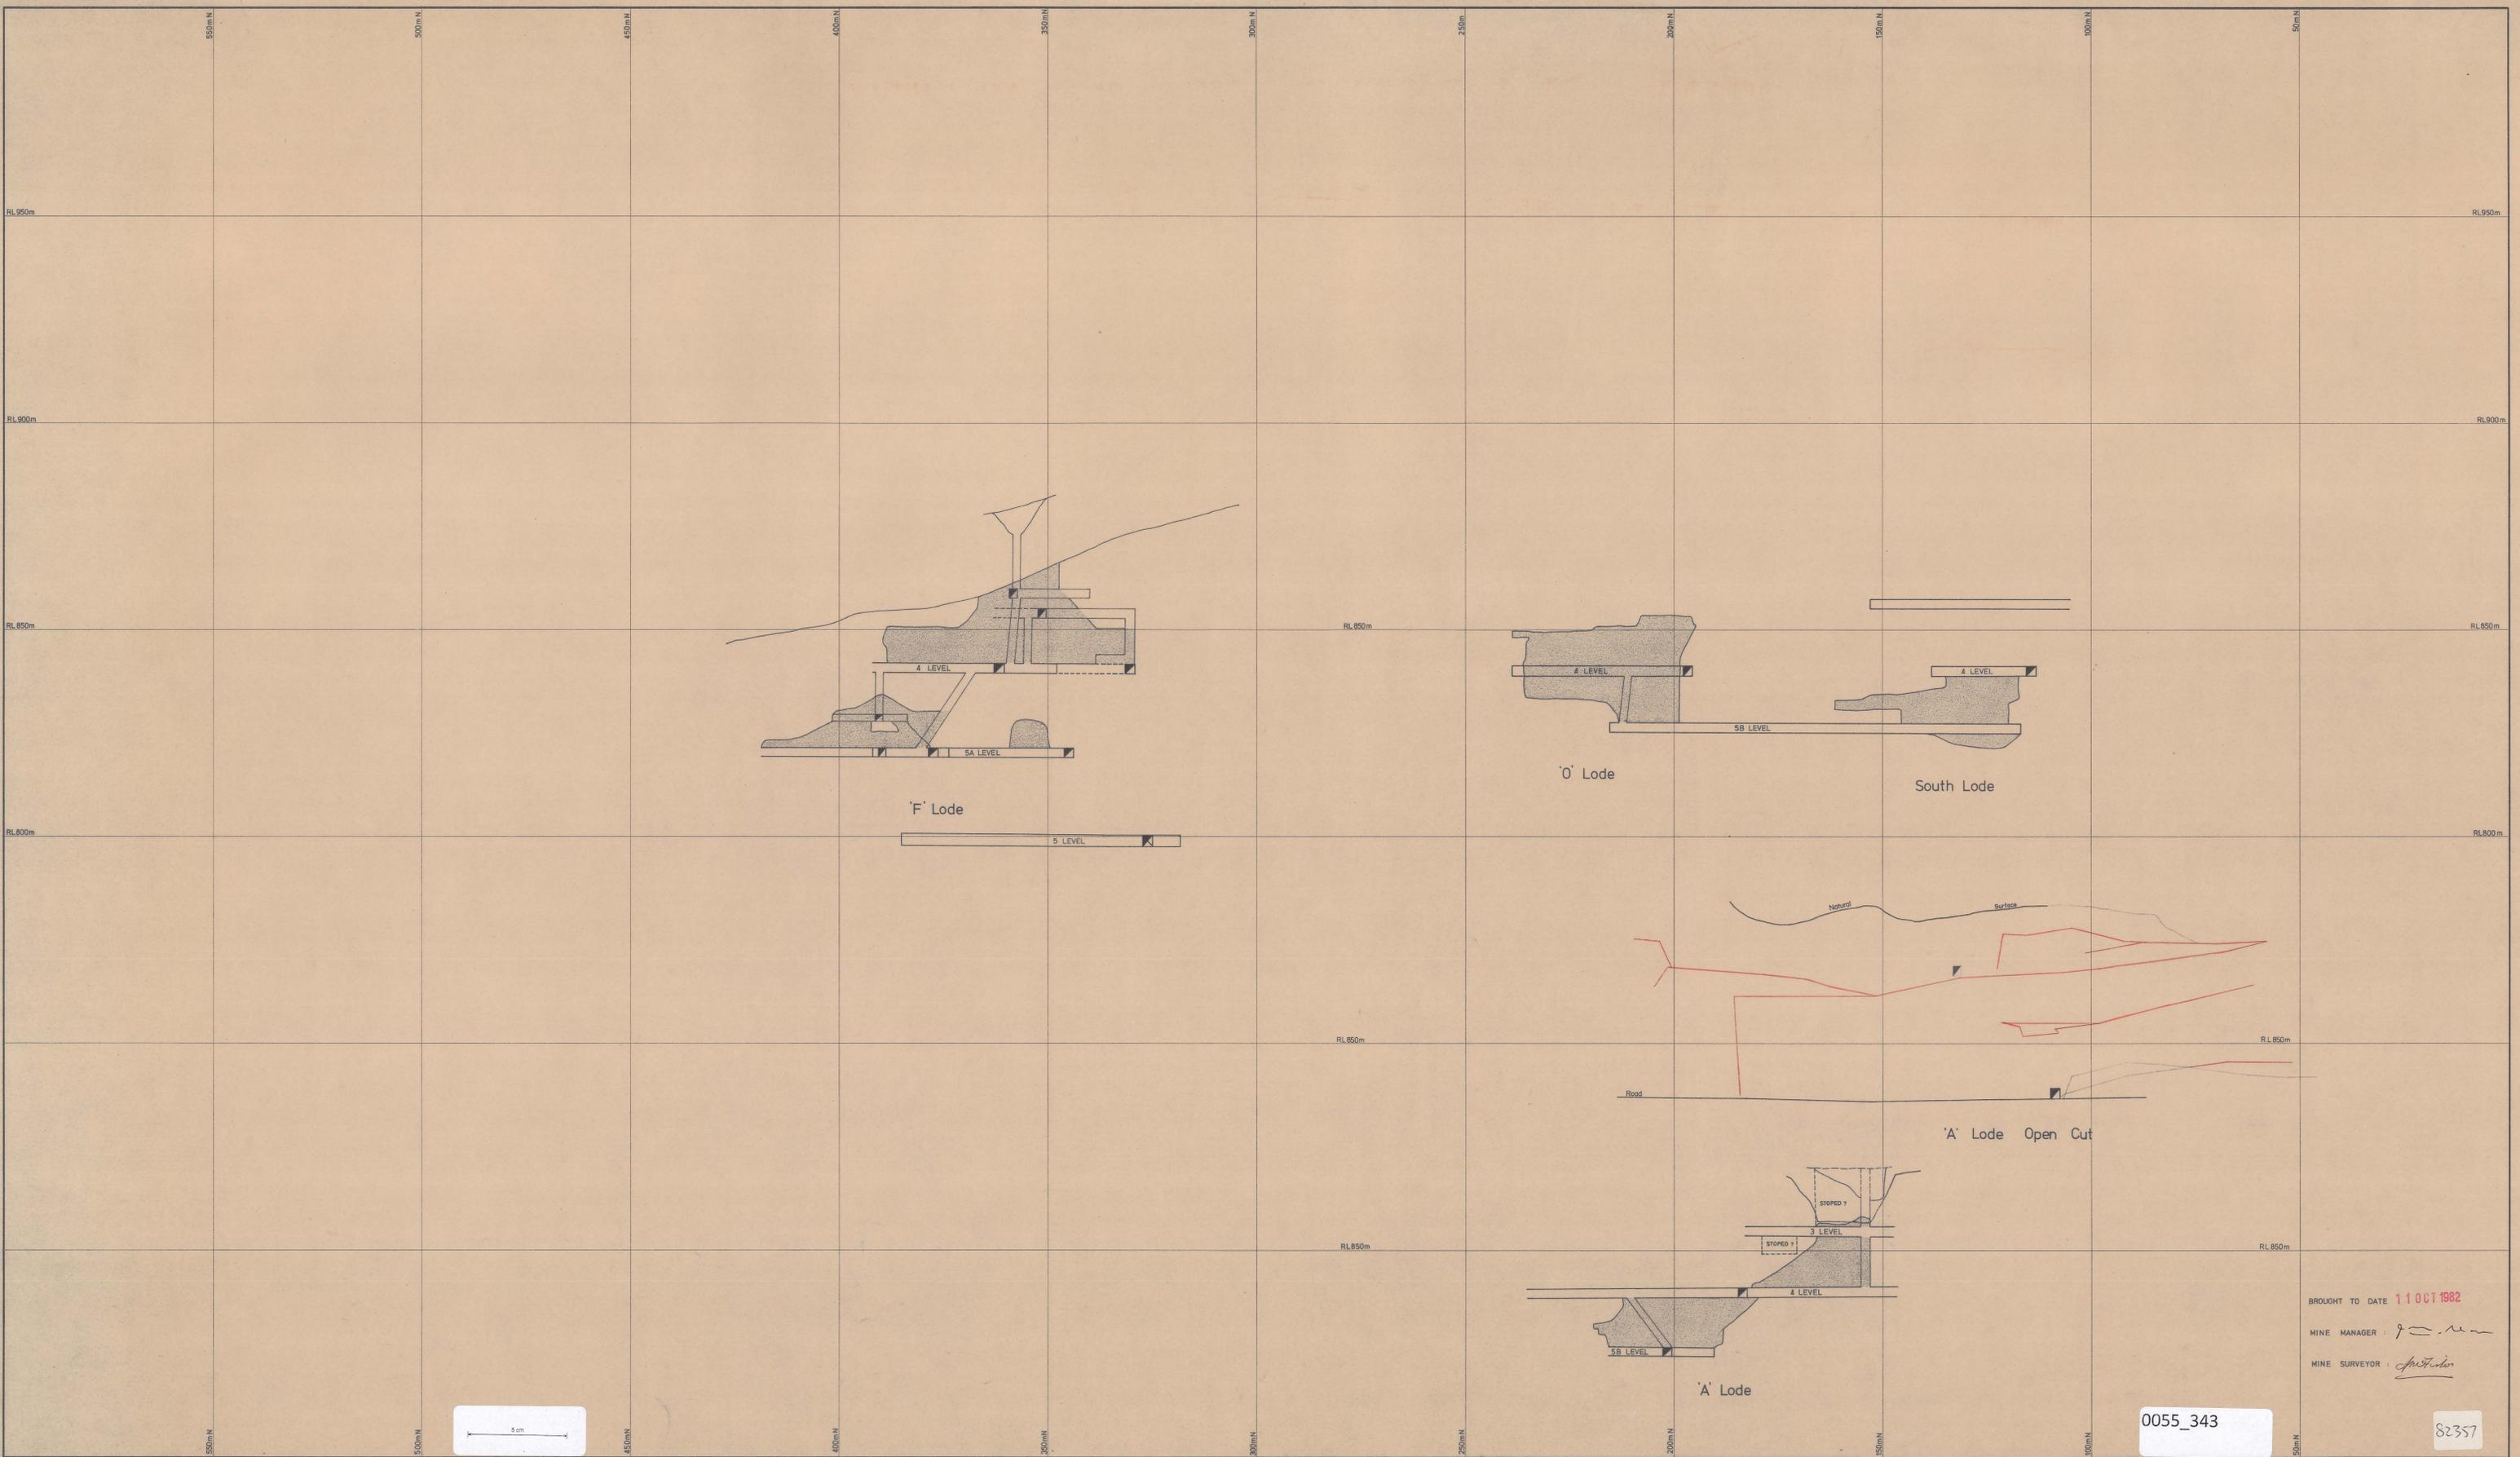

BROUGHT TO DATE 11 OCT 1982
 MINE MANAGER : *[Signature]*
 MINE SURVEYOR : *[Signature]*

0055_343

82357

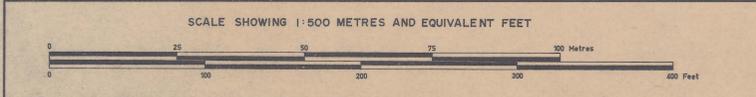

ELECTROLYTIC ZINC COMPANY OF AUSTRALASIA LIMITED
 WEST COAST MINES, T.A.S.

SURVEY BY		SCALE	1 : 500
DRAWN BY		DATE	1973
TRACED BY	P.J. Lowe	REFERENCE	

HERCULES MINE
 LONGITUDINAL PROJECTION

DRAWING NO.:
 DEPARTMENT OF MINES