



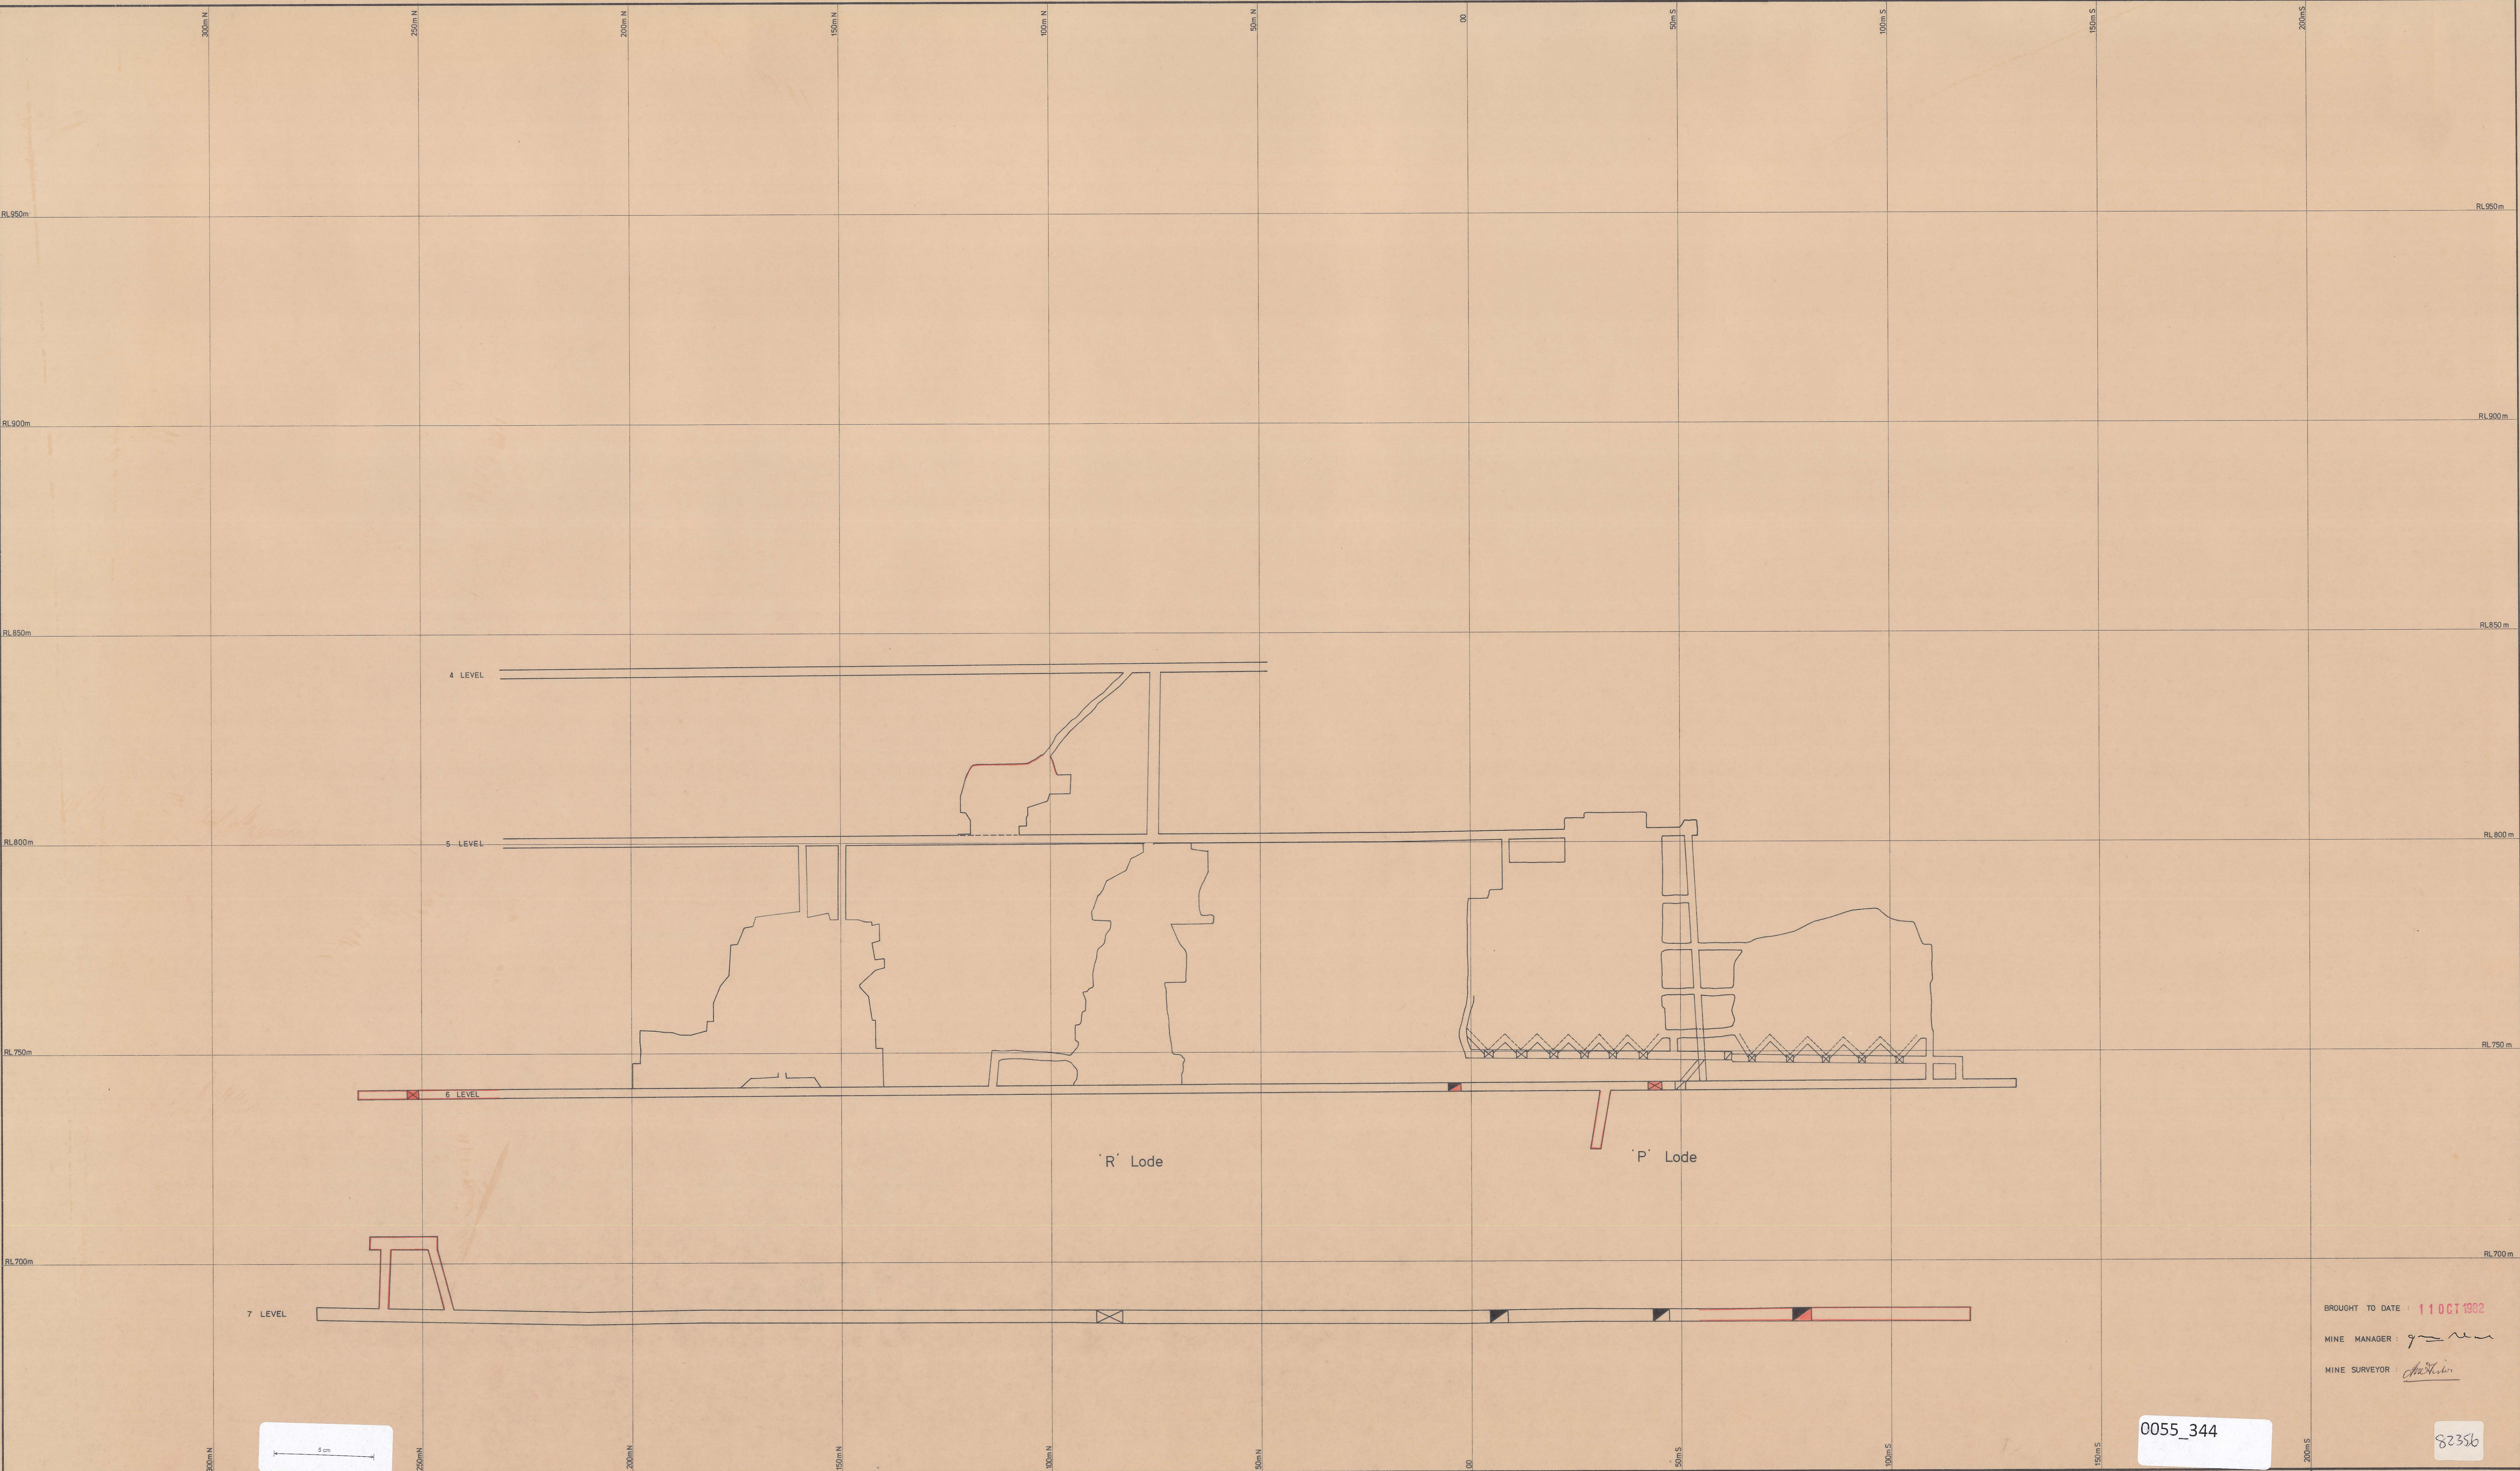

BROUGHT TO DATE : 11 OCT 1992
MINE MANAGER : *[Signature]*
MINE SURVEYOR : *[Signature]*

0055_344

8235b

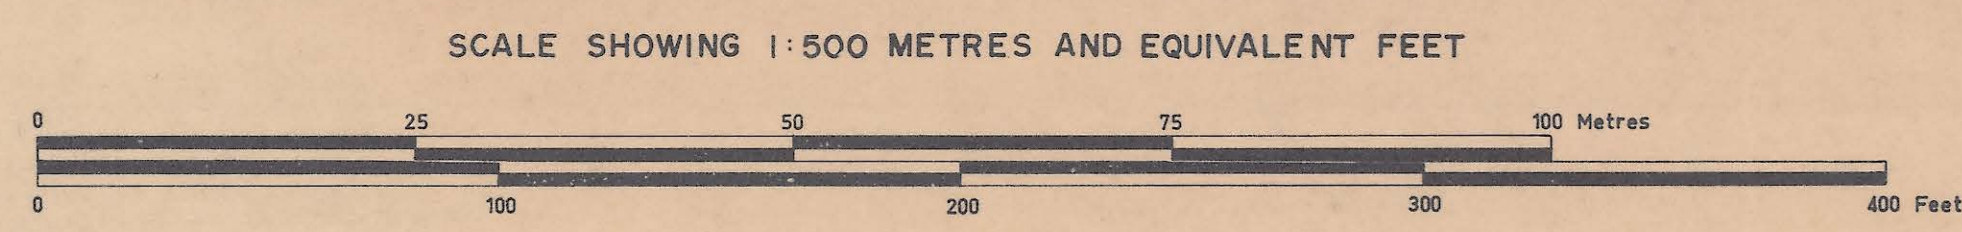

ELECTROLYTIC ZINC COMPANY OF AUSTRALASIA LIMITED
WEST COAST MINES , TAS.

SURVEY BY		SCALE	1 : 500
DRAWN BY		DATE	1973
TRACED BY	P.J. Lowe	REFERENCE	

HERCULES MINE
LONGITUDINAL PROJECTION

DRAWING NO :
DEPARTMENT OF MINES