



0055_347

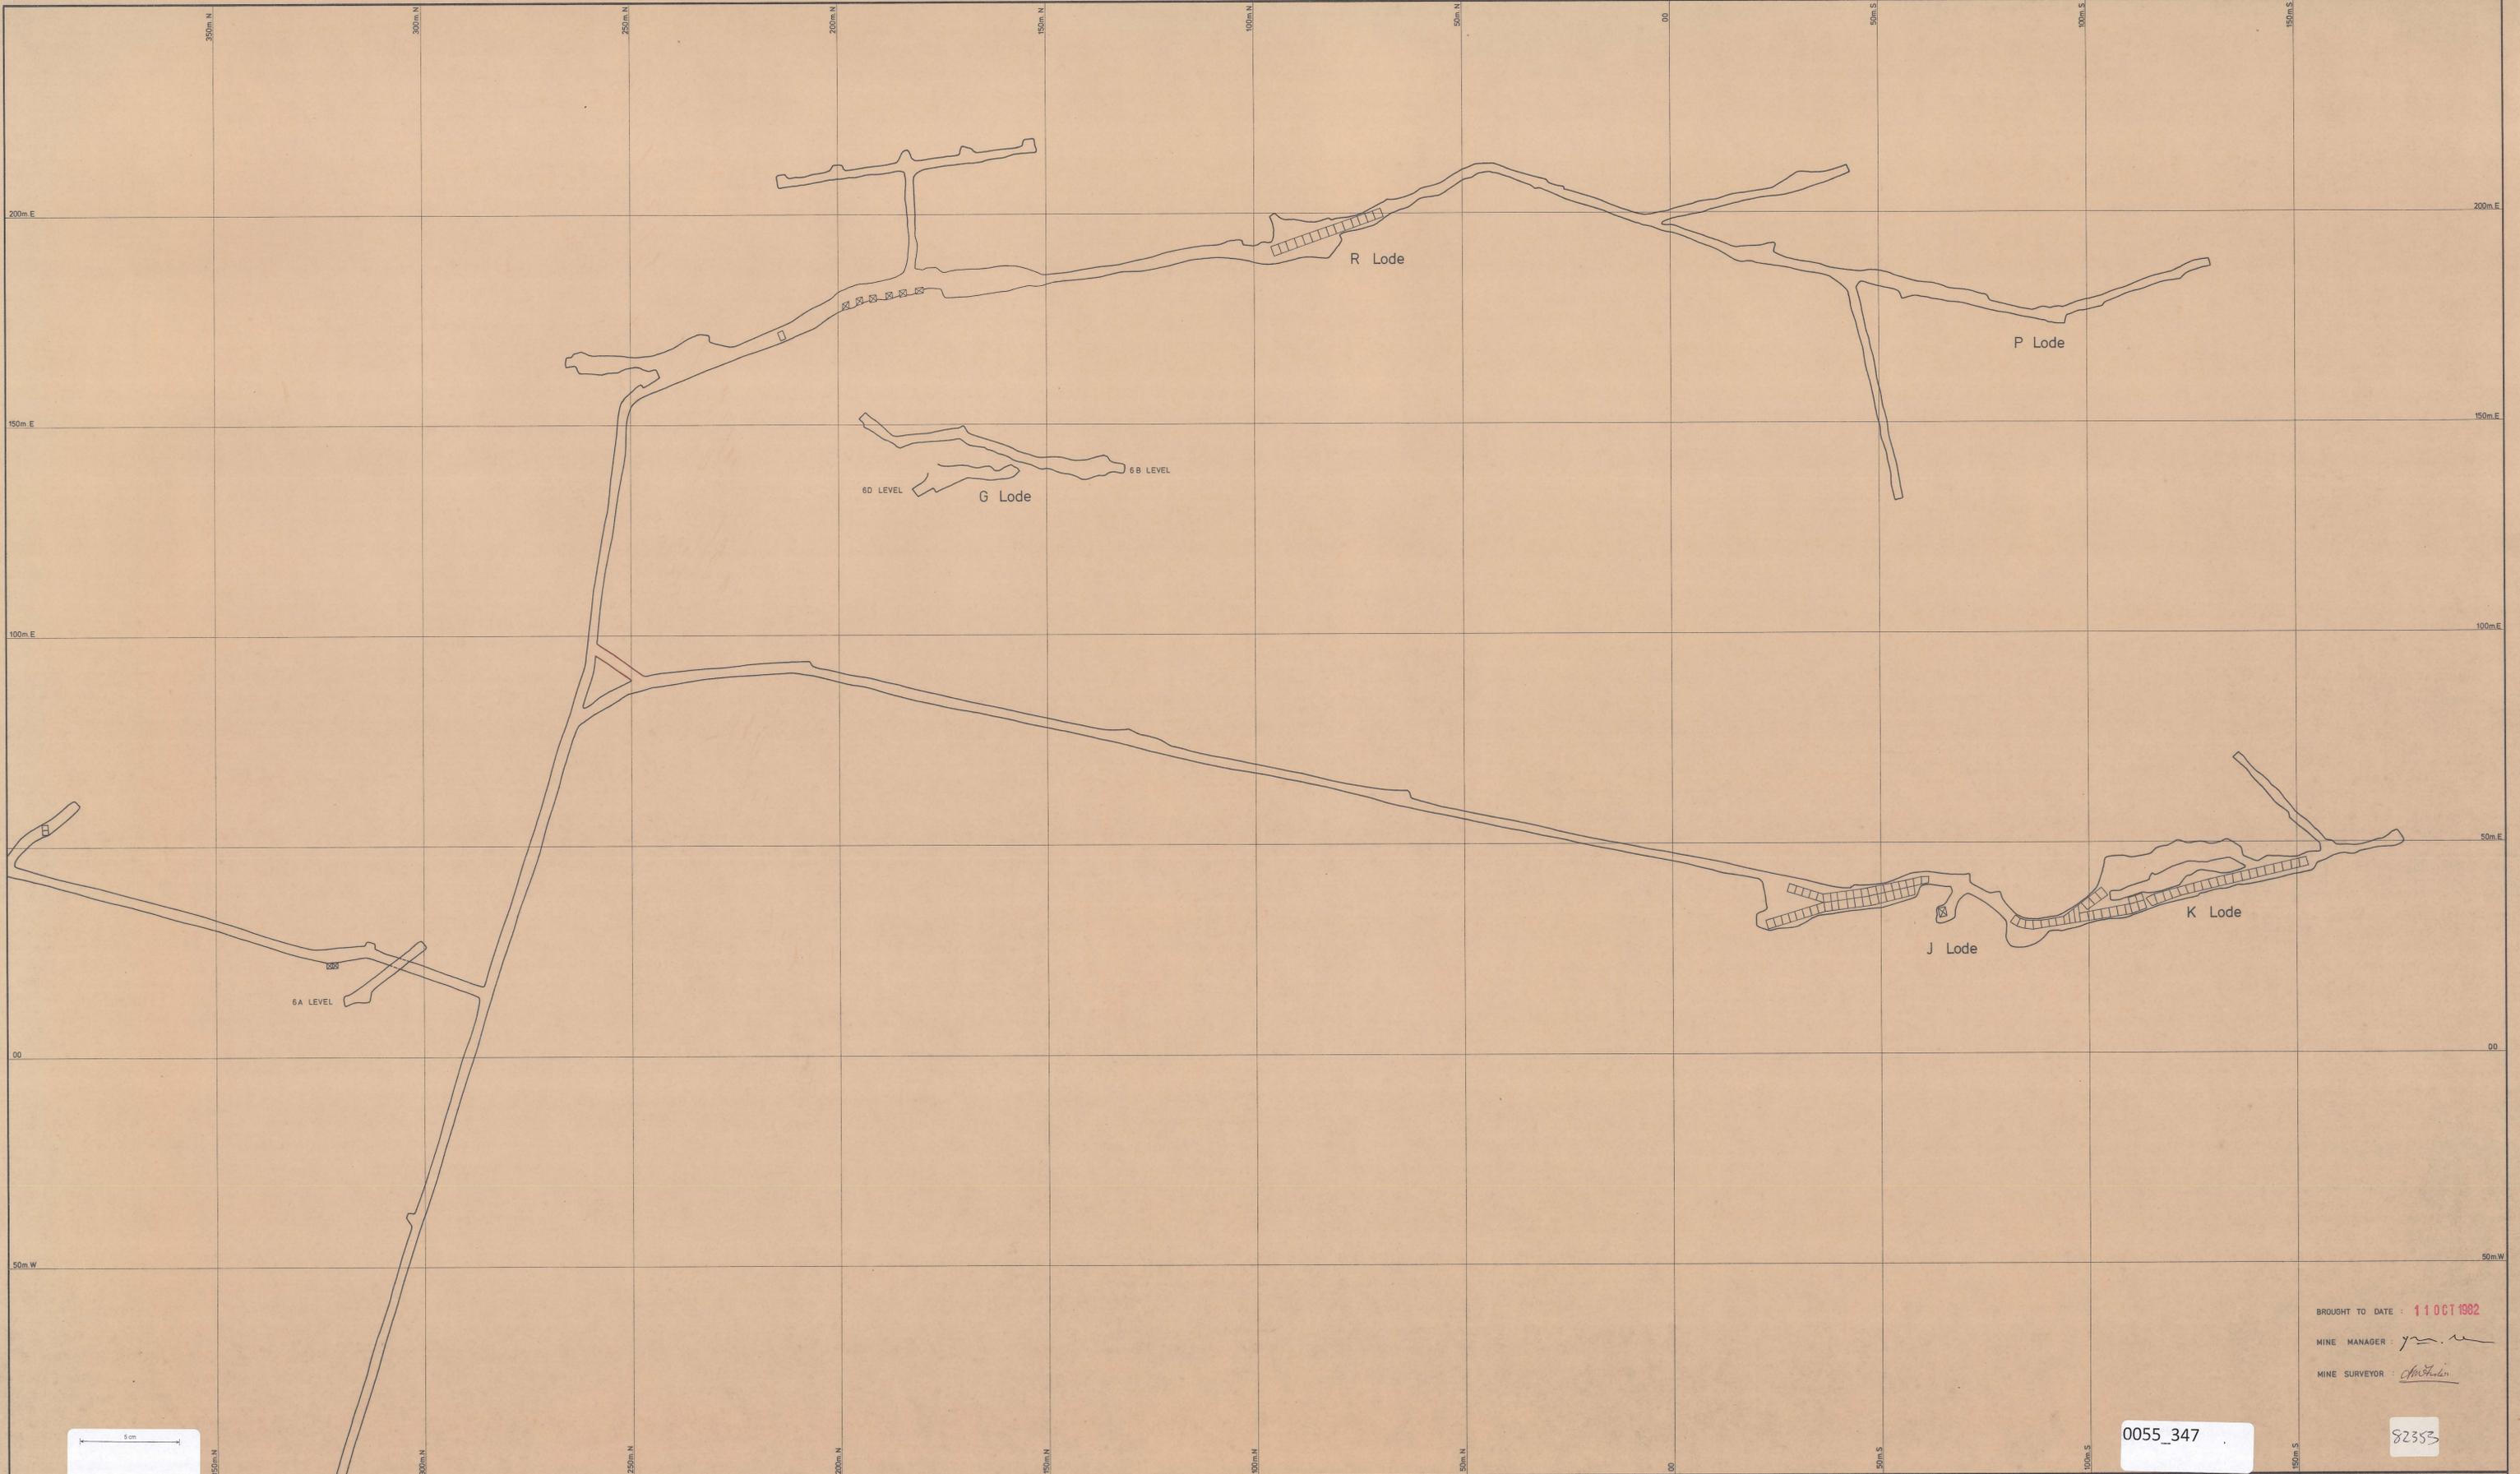

BROUGHT TO DATE : 11 OCT 1982
 MINE MANAGER : *[Signature]*
 MINE SURVEYOR : *[Signature]*

0055_347

82353

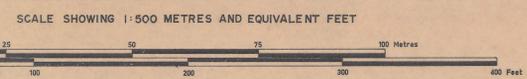

ELECTROLYTIC ZINC COMPANY OF AUSTRALASIA LIMITED
 WEST COAST MINES, T.A.S.

SURVEY BY		SCALE	1 : 500 METRES
DRAWN BY		DATE	1973
TRACED BY	P. J. Lowe	REFERENCE	

HERCULES MINE
 No 6 LEVEL

DRAWING No :
 DEPARTMENT OF MINES
 PLAN