


BROUGHT TO DATE: 11 OCT 1982
 MINE MANAGER: *[Signature]*
 MINE SURVEYOR: *[Signature]*

0055_349

82351

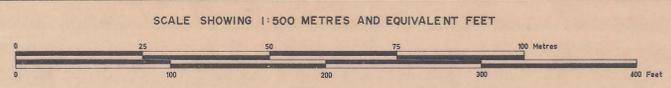

ELECTROLYTIC ZINC COMPANY OF AUSTRALASIA LIMITED
 WEST COAST MINES, T.A.S.

SURVEY BY		SCALE	1 : 500 METRES
DRAWN BY		DATE	1973
TRACED BY	P. J. Lowe	REFERENCE	

HERCULES MINE
 No 4 LEVEL
 00 - 600m.N

DRAWING No:
 DEPARTMENT OF MINES
 PLAN

0055_349