


0055\_353

DEPARTMENT OF MINES  
 BROUGHT TO DATE 11 OCT 1982  
 MINE MANAGER *[Signature]*  
 MINE SURVEYOR *[Signature]*

0055\_353

82347

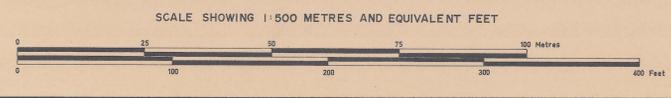

ELECTROLYTIC ZINC COMPANY OF AUSTRALASIA LIMITED  
 WEST COAST MINES, T.A.S.

SURVEY BY		SCALE	1:500
DRAWN BY		DATE	1975
TRACED BY	I.T.M.	REFERENCE	

ROSEBERY MINE  
 No 16 LEVEL (3)

DRAWING No: 

1	2	3
---	---	---