


0055_355

DEPARTMENT OF MINES
 BROUGHT TO DATE: 11 OCT 1982
 MINE MANAGER: *[Signature]*
 MINE SURVEYOR: *[Signature]*

0055_355

82345

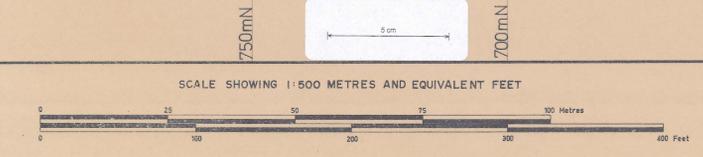

ELECTROLYTIC ZINC COMPANY OF AUSTRALASIA LIMITED
 WEST COAST MINES, T.A.S.

SURVEY BY		SCALE	1:500
DRAWN BY		DATE	1978
TRACED BY	A.G.M.	REFERENCE	

ROSEBERY MINE
 No 16 LEVEL ①

DRAWING No: ①
 ②