


DEPARTMENT OF MINES  
 BROUGHT TO DATE 11 OCT 1982  
 MINE MANAGER *[Signature]*  
 MINE SURVEYOR *[Signature]*

0055\_359

82341

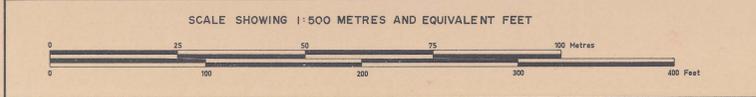

ELECTROLYTIC ZINC COMPANY OF AUSTRALASIA LIMITED  
 WEST COAST MINES, T.A.S.

SURVEY BY		SCALE	1:500
DRAWN BY		DATE	1975
TRACED BY	I.T.M.	REFERENCE	

ROSEBERY MINE  
 No 14 LEVEL (2)

DRAWING No.:

5	6
3	4
1	2

0055\_359