


8cm

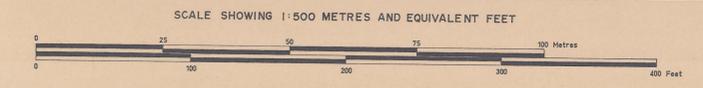

ELECTROLYTIC ZINC COMPANY OF AUSTRALASIA LIMITED  
WEST COAST MINES, T.A.S.

SURVEY BY		SCALE	1:500
DRAWN BY		DATE	1975
TRACED BY	I.T.M.	REFERENCE	

0055\_360

ROSEBERY MINE  
Nº 14 LEVEL (1)

DEPARTMENT OF MINES  
BROUGHT TO DATE 11 OCT 1982  
MINE MANAGER *[Signature]*  
MINE SURVEYOR *[Signature]*

82340

DRAWING N<sup>o</sup>:

3	5	6
4	1	2

0055\_360