



0055_361

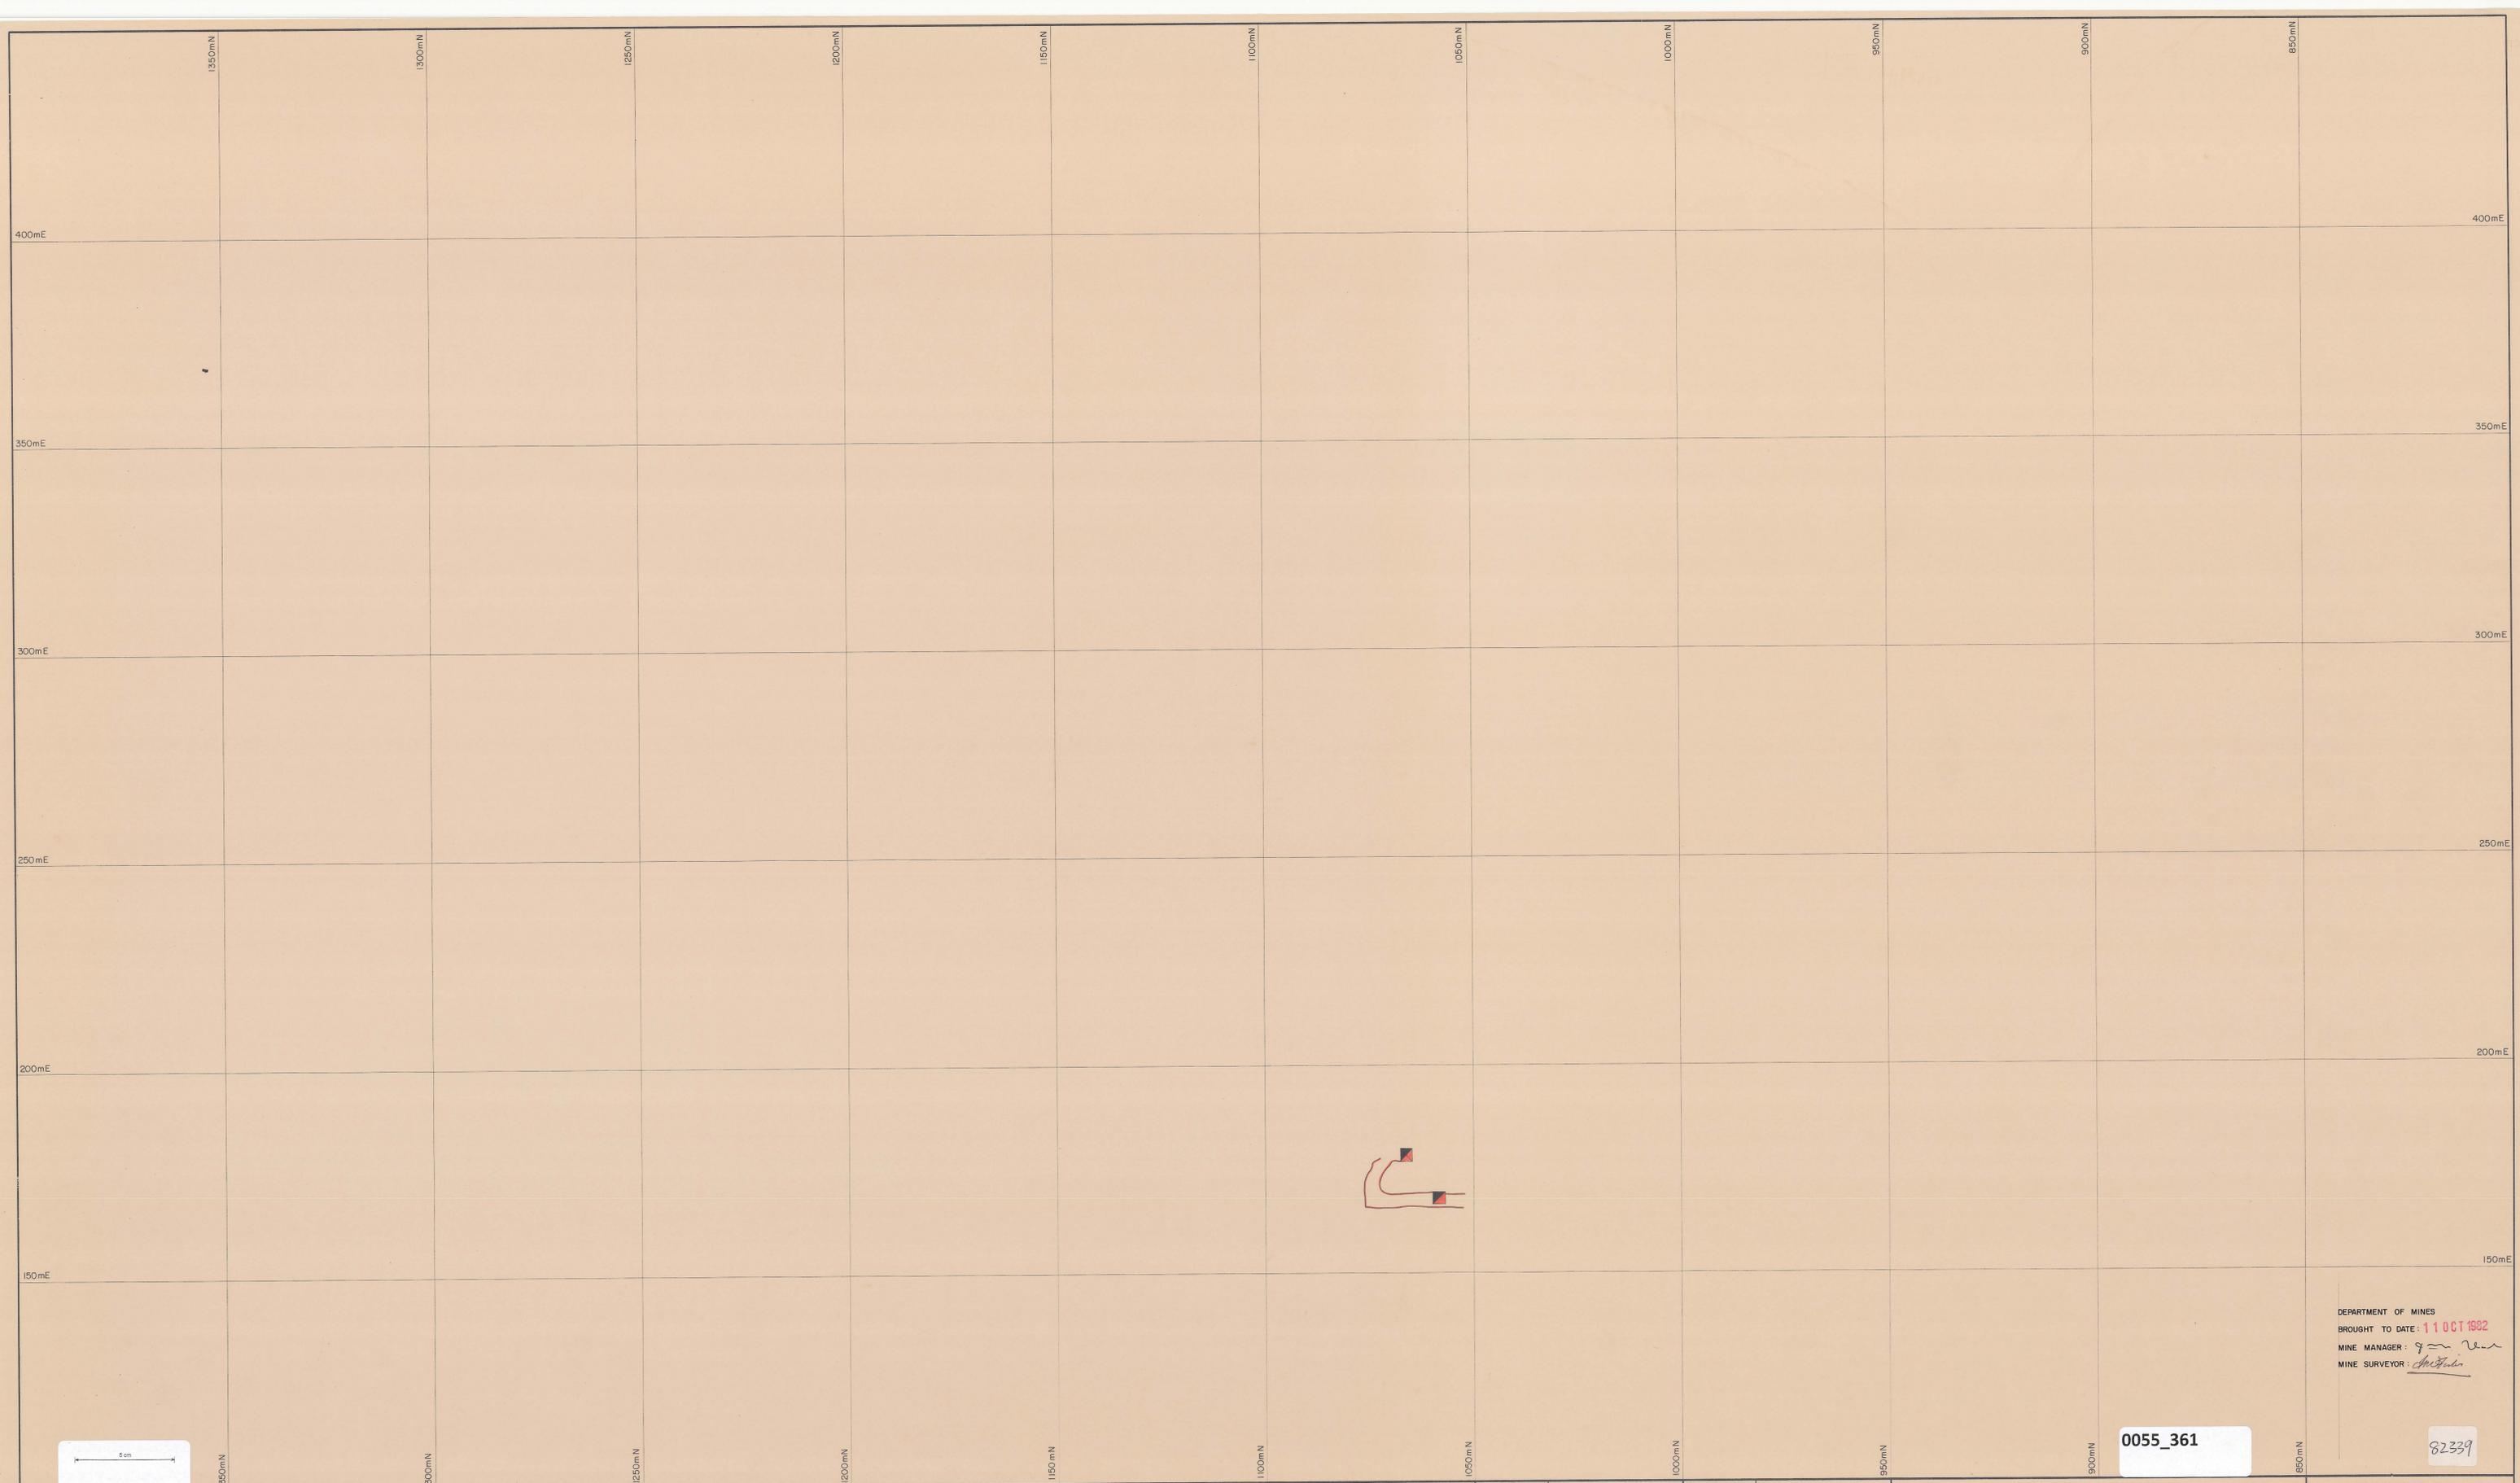

5 cm

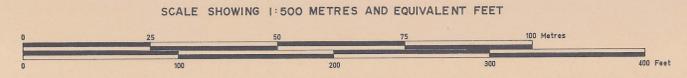

ELECTROLYTIC ZINC COMPANY OF AUSTRALASIA LIMITED
WEST COAST MINES, T.A.S.

SURVEY BY		SCALE	1:500
DRAWN BY	P. J. S.	DATE	11.10.82
TRACED BY	G. M. B.	REFERENCE	

ROSEBERRY MINE
No. 13 LEVEL (3)

0055_361

82339

DEPARTMENT OF MINES
BROUGHT TO DATE: 11 OCT 1982
MINE MANAGER: *[Signature]*
MINE SURVEYOR: *[Signature]*

DRAWING N°:

