


5 cm

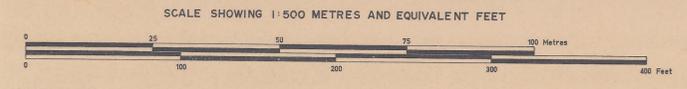

ELECTROLYTIC ZINC COMPANY OF AUSTRALASIA LIMITED
WEST COAST MINES, T.A.S.

| | | | |
|-----------|-----|-----------|-------|
| SURVEY BY | | SCALE | 1:500 |
| DRAWN BY | | DATE | 1975 |
| TRACED BY | RJR | REFERENCE | |

ROSEBERY MINE
No 13 LEVEL (2)

0055_362

82338

DEPARTMENT OF MINES
BROUGHT TO DATE 11 OCT 1982
MINE MANAGER *[Signature]*
MINE SURVEYOR *[Signature]*

DRAWING No:

0055_362