


5m

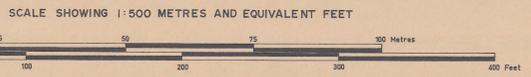

ELECTROLYTIC ZINC COMPANY OF AUSTRALASIA LIMITED
WEST COAST MINES, T.A.S.

SURVEY BY		SCALE	1: 500
DRAWN BY		DATE	1975
TRACED BY	I.T.M.	REFERENCE	

ROSEBERY MINE
No 13 LEVEL (1)

DEPARTMENT OF MINES
BROUGHT TO DATE 11 OCT 1982
MINE MANAGER *g.m. [signature]*
MINE SURVEYOR *[signature]*

0055_363

82337

DRAWING No:

0055_363