


0055_366

DEPARTMENT OF MINES
 BROUGHT TO DATE: 11 OCT 1982
 MINE MANAGER: *[Signature]*
 MINE SURVEYOR: *[Signature]*

0055_366

82334

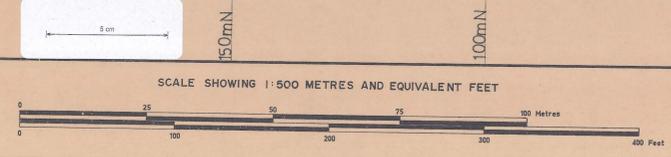

ELECTROLYTIC ZINC COMPANY OF AUSTRALASIA LIMITED
 WEST COAST MINES, T.A.S.

SURVEY BY		SCALE	1:500
DRAWN BY		DATE	1975
TRACED BY	RJR	REFERENCE	

ROSEBERY MINE
 N° 11 LEVEL (3)

DRAWING N°:
 ① ② ③