




0055_369

DEPARTMENT OF MINES
 BROUGHT TO DATE: 11 OCT 1982
 MINE MANAGER: *[Signature]*
 MINE SURVEYOR: *[Signature]*

0055_369

82331

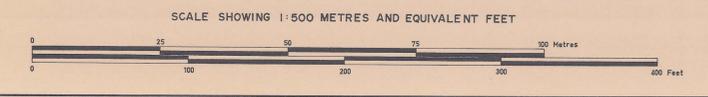

ELECTROLYTIC ZINC COMPANY OF AUSTRALASIA LIMITED
 WEST COAST MINES, T.A.S.

SURVEY BY		SCALE	1:500
DRAWN BY		DATE	23.09.82
TRACED BY	G.M. BENNETT	REFERENCE	

ROSEBERY MINE
 DEVELOPMENT PLAN
 DECLINE SPECIAL, Sheet 3

DRAWING N°: