
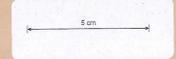


0055_373

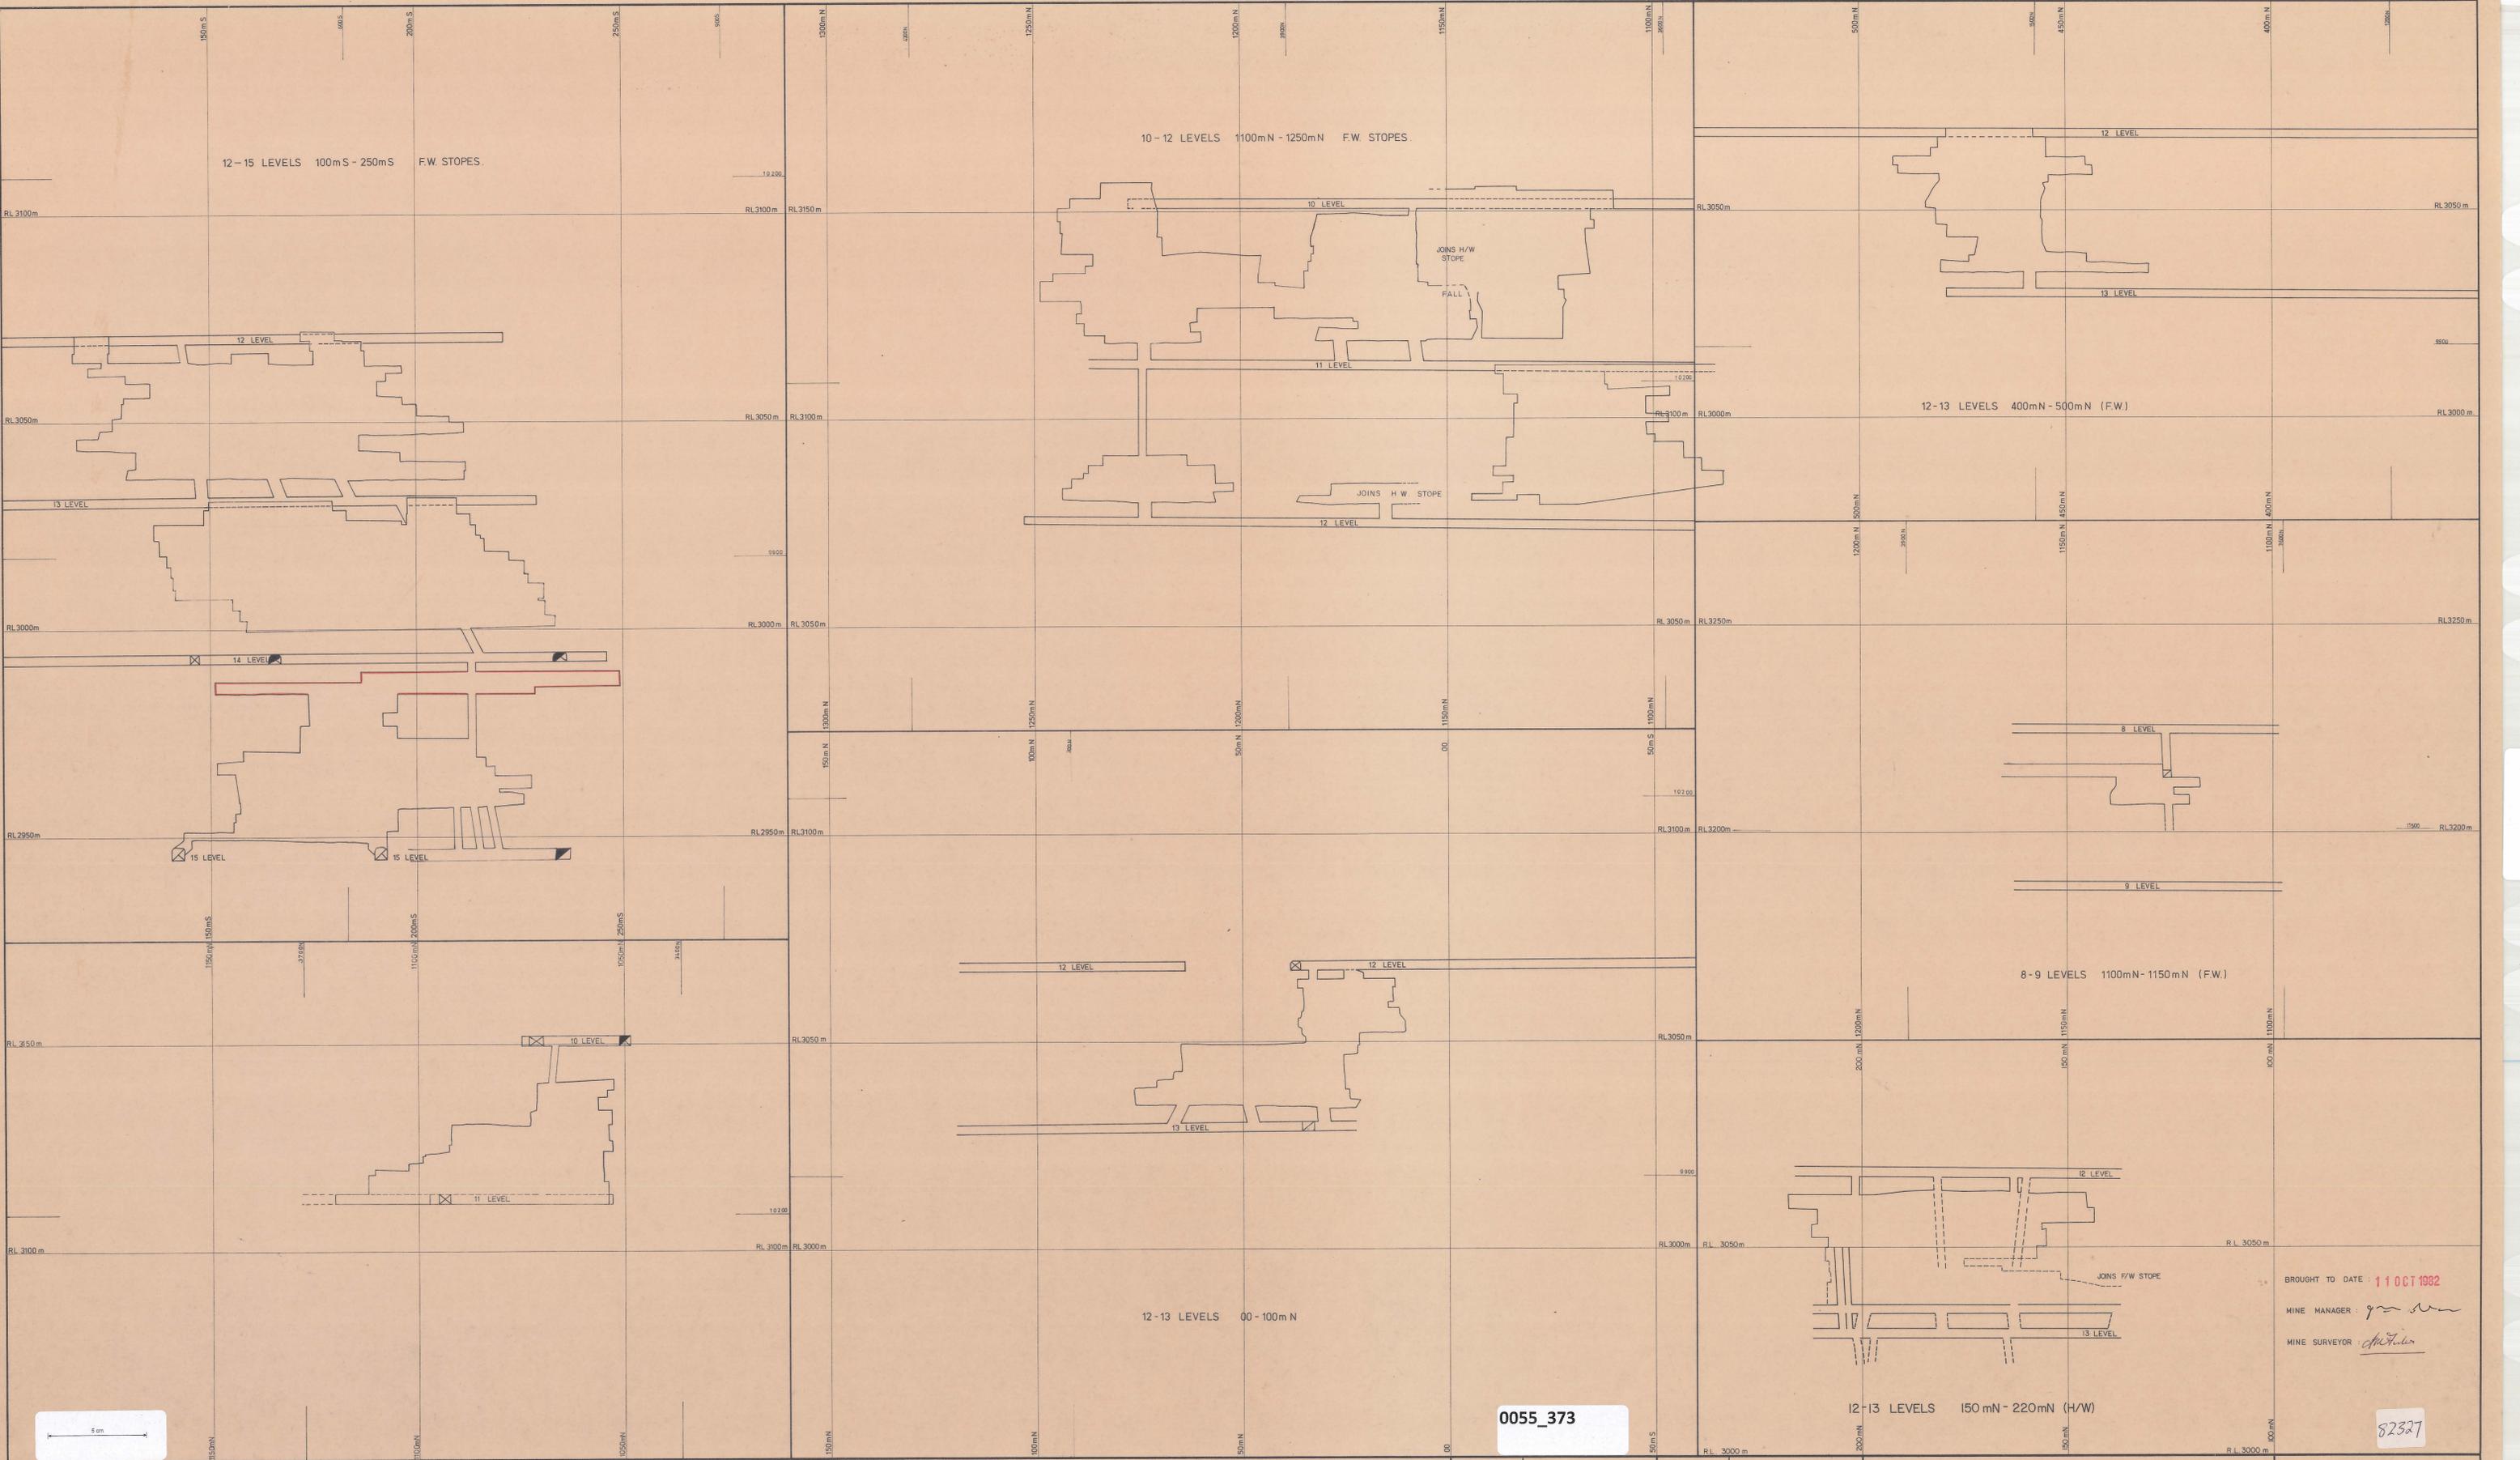

SCALE SHOWING 1:500 METRES AND EQUIVALENT FEET

ELECTROLYTIC ZINC COMPANY OF AUSTRALASIA LIMITED
WEST COAST MINES, T.A.S.

SURVEY BY
DRAWN BY
TRACED BY P. J. Lowe

SCALE 1:500
DATE 1973
REFERENCE

ROSEBERY MINE
LONGITUDINAL PROJECTION
SPECIFIC STOPES.

BROUGHT TO DATE: 11 OCT 1982
MINE MANAGER: *[Signature]*
MINE SURVEYOR: *[Signature]*

DRAWING NO: 82527

DEPARTMENT OF MINES