


OBLIQUE LONG SECTION
Bearing of slots = 305°

BROUGHT TO DATE : 11 OCT 1992
 MINE MANAGER *[Signature]*
 MINE SURVEYOR *[Signature]*

0055_374

82326

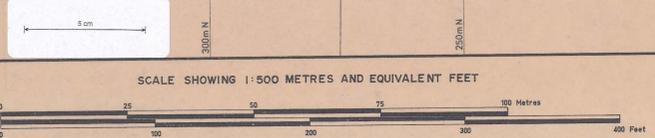

ELECTROLYTIC ZINC COMPANY OF AUSTRALASIA LIMITED
 WEST COAST MINES, T.A.S.

SURVEY BY	SCALE	1 : 500
DRAWN BY	DATE	1973
TRACED BY P. J. Lowe	REFERENCE	

ROSEBERY MINE
 LONGITUDINAL PROJECTION
 SPECIFIC STOPES

DRAWING N° :
 DEPARTMENT OF MINES