


5 cm

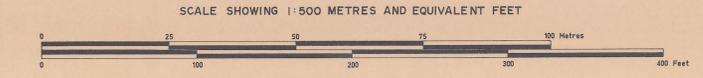

ELECTROLYTIC ZINC COMPANY OF AUSTRALASIA LIMITED
WEST COAST MINES, T.A.S.

SURVEY BY		SCALE	1:500
DRAWN BY		DATE	24-09-82
TRACED BY		REFERENCE	

0055_375

ROSEBERY MINE
LONGITUDINAL PROJECTION
DECLINE SPECIAL

DEPARTMENT OF MINES 11 OCT 1982
BROUGHT TO DATE:
MINE MANAGER: *[Signature]*
MINE SURVEYOR: *[Signature]*

82325

DRAWING N°:
DEPARTMENT OF MINES

0055_375