

RL 2950m

RL 2900m

RL 2850m

RL 2800m

RL 2750m

RL 2700m

500mN

450mN

400mN

350mN

300mN

250mN

200mN

150mN

100mN

50mN

00

16 LEVEL

17 LEVEL

BULK STOPES MINED


BROUGHT TO DATE 11 OCT 1982

MINE MANAGER: *[Signature]*

MINE SURVEYOR: *[Signature]*

0055_377

82323

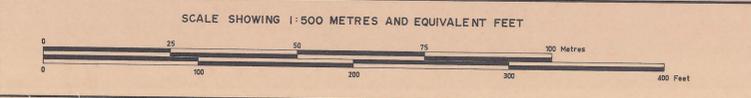

ELECTROLYTIC ZINC COMPANY OF AUSTRALASIA LIMITED
WEST COAST MINES, T.A.S.

SURVEY BY		SCALE	1:500
DRAWN BY	A. G. MORRISON	DATE	19.01.79
TRACED BY	A. G. M.	REFERENCE	

ROSEBERY MINE
LONGITUDINAL PROJECTION
'H' LENS. H/W STOPE
50mS-550mN BELOW 15 LEVEL

DRAWING N°:
DEPARTMENT OF MINES

0055_377