

0055\_378




0055\_378

BULK STOPES MINED

BROUGHT TO DATE: 11 OCT 1982  
 MINE MANAGER: *[Signature]*  
 MINE SURVEYOR: *[Signature]*

82322

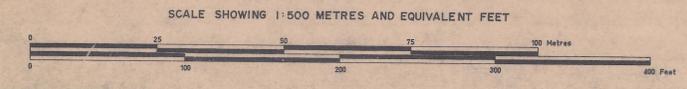

ELECTROLYTIC ZINC COMPANY OF AUSTRALASIA LIMITED  
 WEST COAST MINES, T.A.S.

SURVEY BY	SCALE	1:500 metres
DRAWN BY	DATE	1973
TRACED BY S.M. Burrows	REFERENCE	

ROSEBERY MINE  
 LONGITUDINAL PROJECTION  
 400mS-200mN - BELOW 10/L

DRAWING N°:  
 DEPARTMENT OF MINES