


5 cm

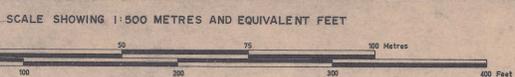

**ELECTROLYTIC ZINC COMPANY OF AUSTRALASIA LIMITED**  
WEST COAST MINES, T.A.S.

SURVEY BY		SCALE	1 : 500
DRAWN BY		DATE	1973
TRACED BY	P.J. Lowe	REFERENCE	

0055\_379

ROSEBERY MINE  
LONGITUDINAL PROJECTION  
200mN - 800mN - BELOW 10/L.

BROUGHT TO DATE: 11 OCT 1982  
MINE MANAGER: *[Signature]*  
MINE SURVEYOR: *[Signature]*

DRAWING NO:   
DEPARTMENT OF MINES

82321

0055\_379