
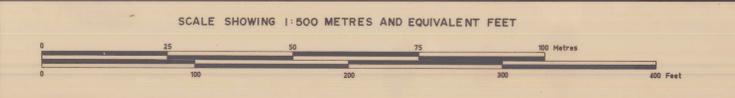


0055_383

MICROFILMED

DEPARTMENT OF MINES
 BROUGHT TO DATE: 31.12.75
 MINE MANAGER: *[Signature]*
 MINE SURVEYOR: *[Signature]*

0055_383

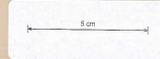

ELECTROLYTIC ZINC COMPANY OF AUSTRALASIA LIMITED
 WEST COAST MINES, T.A.S.

SURVEY BY		SCALE	1:500
DRAWN BY		DATE	1975
TRACED BY	ITM.	REFERENCE	

ROSEBERRY MINE
 COMPOSITE ①
 MAIN HAULAGE X-CUT - SINKING BANK X-CUT

DRAWING N^o:
 ③
 ②
 ①
 76029