
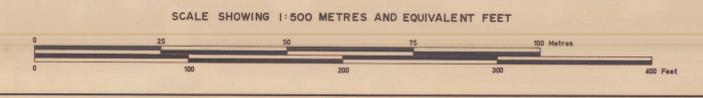


0055_385

MICROFILMED

DEPARTMENT OF MINES
 BROUGHT TO DATE: 31-12-75
 MINE MANAGER: *[Signature]*
 MINE SURVEYOR: *[Signature]*

0055_385

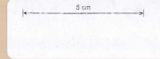

ELECTROLYTIC ZINC COMPANY OF AUSTRALASIA LIMITED
 WEST COAST MINES, T.A.S.

SURVEY BY		SCALE	1:500
DRAWN BY		DATE	1975
TRACED BY	RJR	REFERENCE	

ROSEBERY MINE
 N^o 2 LEVEL (1)

DRAWING N^o:

(1) (2)

7684