


0055_389

MICROFILMED

DEPARTMENT OF MINES
 BROUGHT TO DATE: 31.12.75
 MINE MANAGER: *[Signature]*
 MINE SURVEYOR: *[Signature]*

0055_389

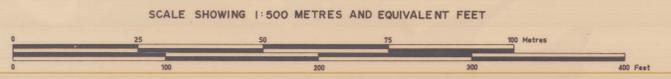

ELECTROLYTIC ZINC COMPANY OF AUSTRALASIA LIMITED
 WEST COAST MINES, TAS.

SURVEY BY		SCALE	1:500
DRAWN BY		DATE	1975
TRACED BY	I.T.M.	REFERENCE	

ROSEBERY MINE
 COMPOSITE (2)
 MAIN HAULAGE X-CUT - SINKING BANK X-CUT

DRAWING N°:
 (3)
 (2)
 (1)
 76030