


0055\_390

0055\_390



MODIFIED

DEPARTMENT OF MINES  
 BROUGHT TO DATE: 31-12-75  
 MINE MANAGER: *[Signature]*  
 MINE SURVEYOR: *[Signature]*

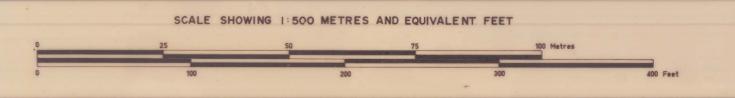

ELECTROLYTIC ZINC COMPANY OF AUSTRALASIA LIMITED  
 WEST COAST MINES, T.A.S.

SURVEY BY	SCALE	1:500
DRAWN BY	DATE	1975
TRACED BY RJR	REFERENCE	

ROSEBERY MINE  
 No 9 LEVEL (3)

DRAWING No:   
 ① ② ③

750/46