


0055_391

MICROFILMED

DEPARTMENT OF MINES
 BROUGHT TO DATE: 31-12-75
 MINE MANAGER: *P. King*
 MINE SURVEYOR: *[Signature]*

0055_391

50m

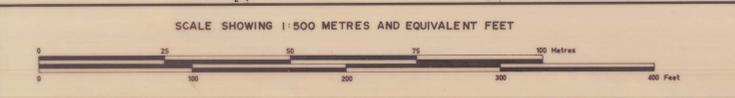

ELECTROLYTIC ZINC COMPANY OF AUSTRALASIA LIMITED
 WEST COAST MINES, T.A.S.

SURVEY BY		SCALE	1:500
DRAWN BY		DATE	1975
TRACED BY	RJR	REFERENCE	

ROSEBERY MINE
 N^o 9 LEVEL ②

DRAWING N^o:
 ① ② ③

7895