


0055_392

MICROFILMED

DEPARTMENT OF MINES
 BROUGHT TO DATE: 31-12-75
 MINE MANAGER *[Signature]*
 MINE SURVEYOR *[Signature]*

0055_392

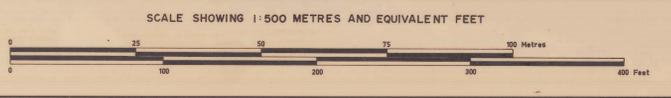

ELECTROLYTIC ZINC COMPANY OF AUSTRALASIA LIMITED
 WEST COAST MINES, T.A.S.

SURVEY BY		SCALE	1:500
DRAWN BY		DATE	1975
TRACED BY	RJR	REFERENCE	

ROSEBERY MINE
 N° 9 LEVEL ①

DRAWING N°:
 ① ② ③

2004